


G-5542  
47715

T.40S.R.11 & 12E.W.M.

RECEIVED  
MAR 14 1972  
STATE ENGINEER  
SALEM OREGON

East River wells

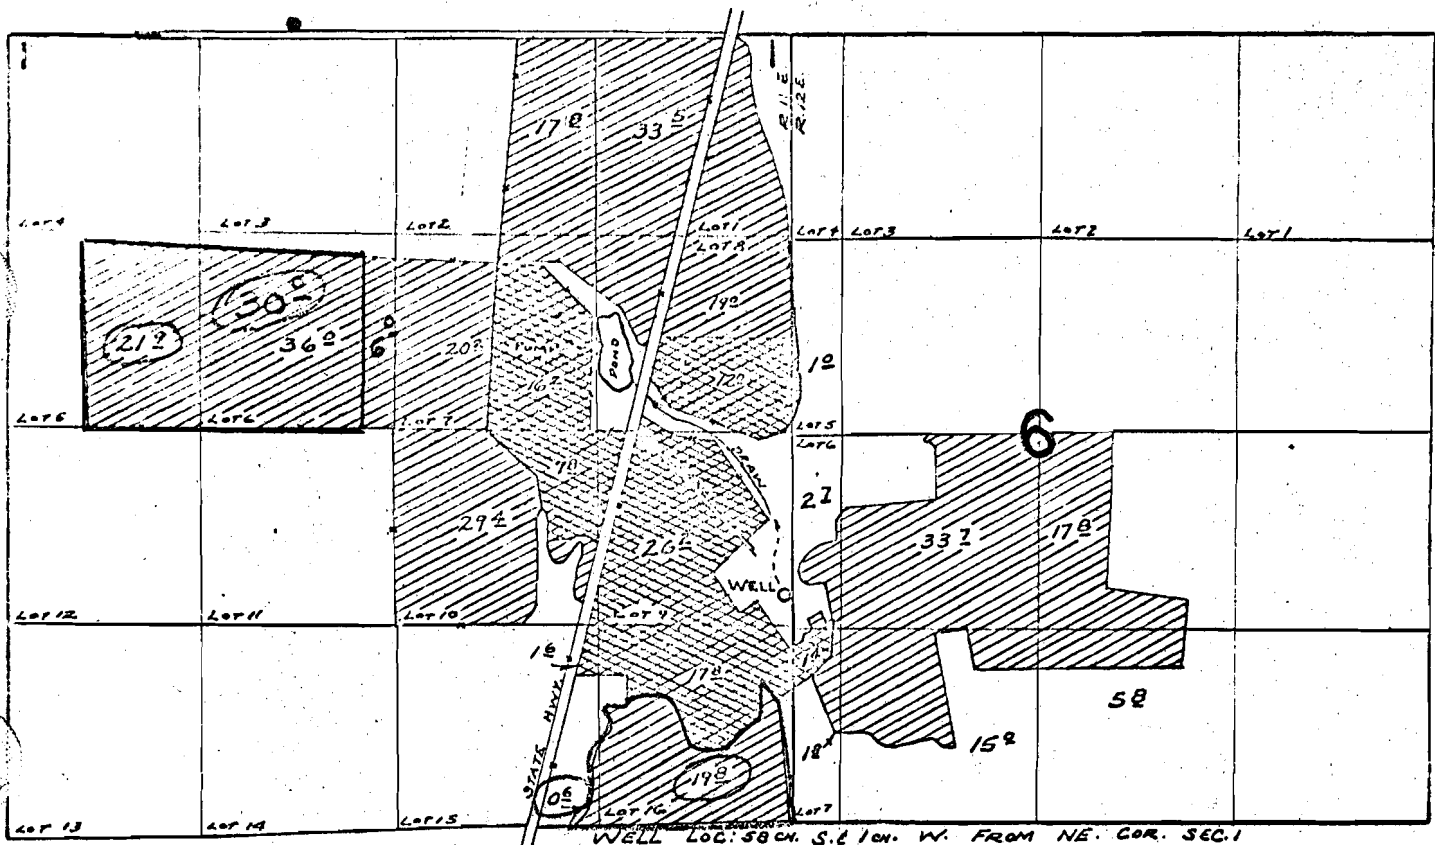

 PRIMARY
  SUPPLEMENTAL

(X) NEW APPLICATION

FINAL PROOF SURVEY  
UNDER

Application No. G-5757  
Permit No. G-5542

Application No. G-3311... Permit No. G-3004...  
IN NAME OF

MARGARET WILLNETTA FREUER...

Surveyed OCT. 28, 1970, by G. BAGA.....