


G-6643
47716

T. 41 S. R. 14 E. W.M.

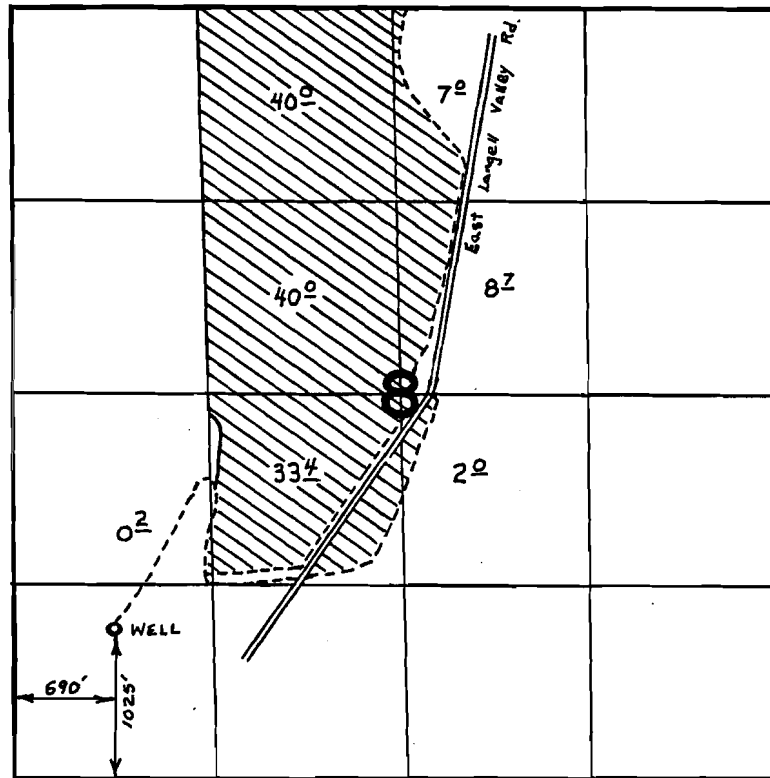

E.B. lost finer wells

FINAL PROOF SURVEY UNDER

Application No. G-7230 Permit No. G-6643
IN NAME OF

SCHMOE, KILGORE, & KILGORE

Surveyed Aug. 25, 1977, by D. Norby