


G-6004  
T8277  
47718

T.27S. R.15E., W.M.

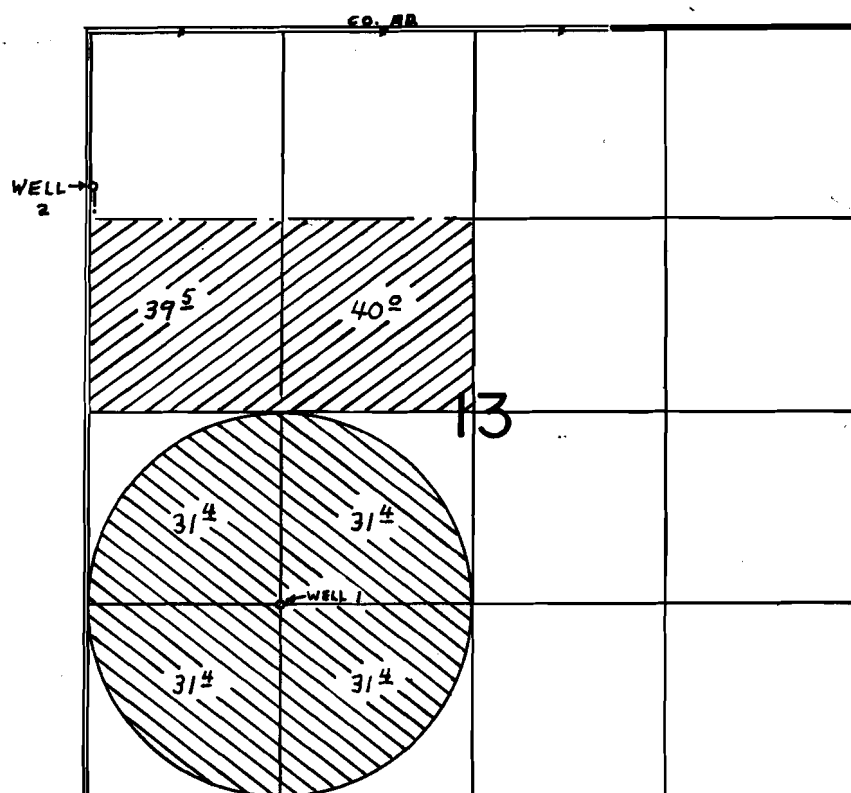

WELL 2 LOC. 1070'S. & 40'E FROM N.W. COR. SEC. 13  
WELL 1 LOC. 1320'E & 396DS. FROM N.W. COR. SEC. 13

APP'L. G-6736 : WELL 2  
APP'L. G-6737 : WELL 1

# FINAL PROOF SURVEY UNDER

G-6736 G-6004  
Application No. G-6737 Permit No. G-6005  
IN NAME OF

DOWERS FARMS

Surveyed JUL 18, 1977, by D.M. NORBY

CHZ-45K-161

CHZ-45K-163

002