


G-6005
47719

T.27S. R.15E., W.M.

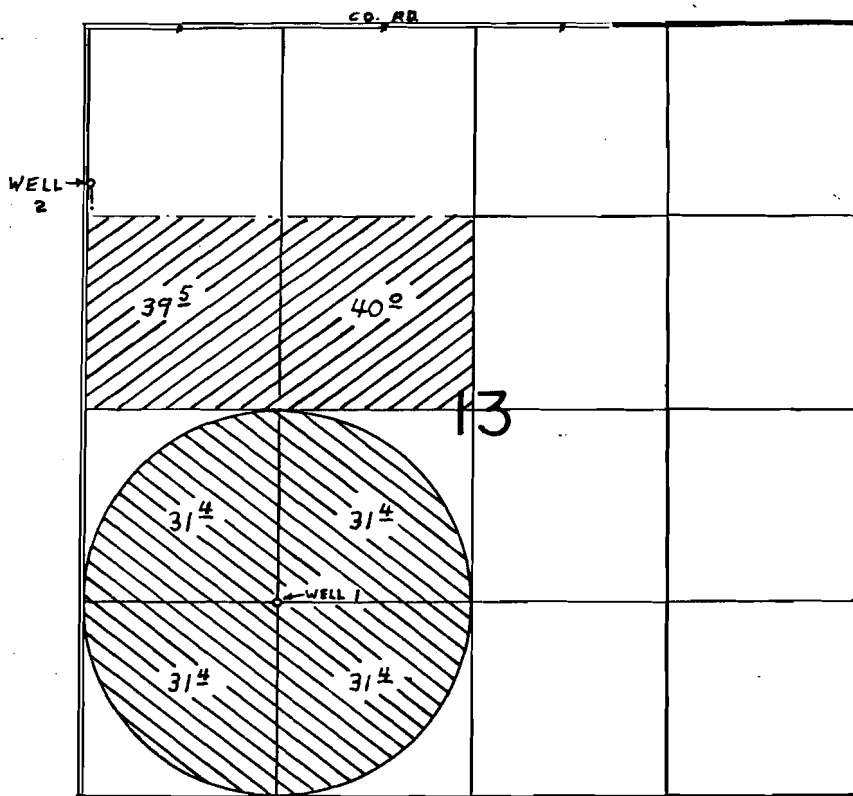

WELL 2 LOC. 1070' S. & 40' E. FROM N.W. COR. SEC. 13
WELL 1 LOC. 1320' E. & 3960' S. FROM N.W. COR. SEC. 13

APP'L. G-6736 : WELL 2
APP'L. G-6737 : WELL 1

FINAL PROOF SURVEY UNDER

G-6736 G-6004
Application No. G-6737 Permit No. G-6005
IN NAME OF

DOWERS FARMS

Surveyed JUL 18, 1977, by D.M. NORBY