G-6450
47720

T.26S. R.15E., W.M.

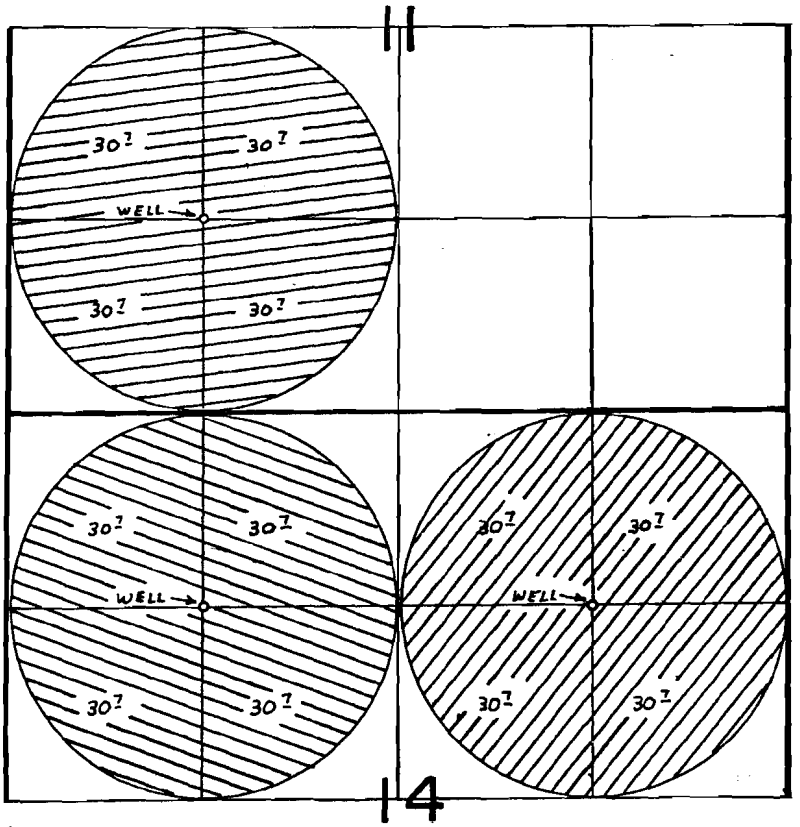

App'l G-6932 ; WELL LOC. 1320'N. & 1320'E. FROM S.W. COR. SEC. 11

App'l G-6935; WELL LOC. 1320'S. & 1330'E. FROM N.W. COR. SEC. 14

App'l G-6933; WELL LOC. 1330'S & 1320'W. FROM N.E. COR. SEC 14

FINAL PROOF SURVEY

UNDER

G-6932 G-6450
G-6933 G-6451
Application No. G-6935 Permit No. G-6453

IN NAME OF

DOWERS FARMS, INC.

Surveyed JUL 18, 1977, by D. M. NORBY

CHZ-1KK-90 ecf