


G-6451
47721

T.26S. R.15E., W.M.

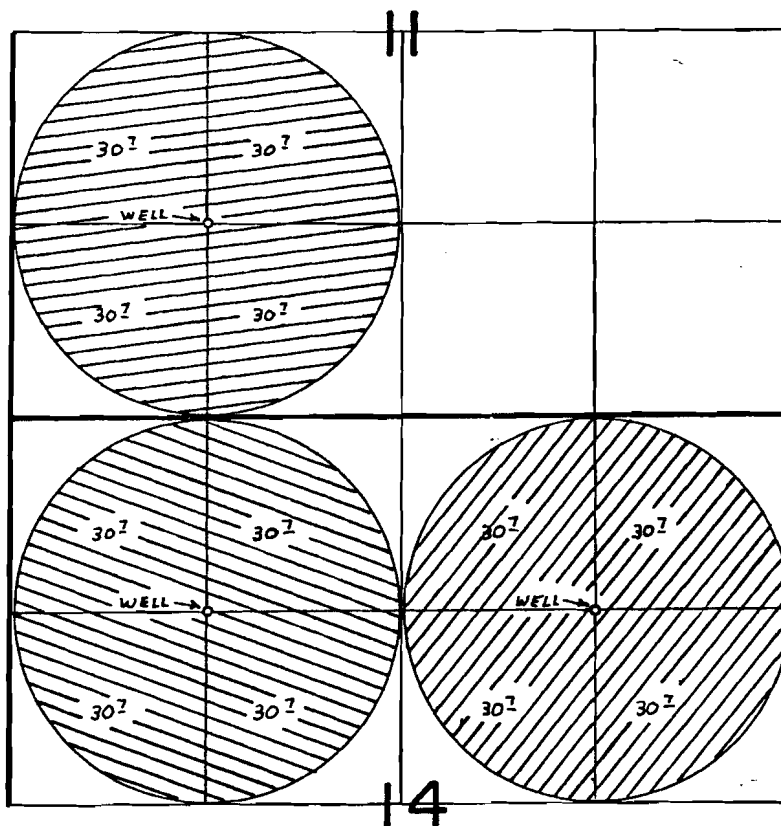

-  APP'L G-6932; WELL LOC. 1320'N. & 1320'E. FROM S.W. COR. SEC. 11
-  APP'L G-6935; WELL LOC. 1320'S. & 1320'E. FROM N.W. COR. SEC. 14
-  APP'L G-6933; WELL LOC. 1330'S & 1320'W. FROM N.E. COR. SEC. 14

FINAL PROOF SURVEY
UNDER

G-6932 G-6450
G-6933 G-6451
Application No. G-6935... Permit No. G-6453...
IN NAME OF

.....DOWERS FARMS, INC.....

Surveyed JUL 18, 1977, by D. M. NORBY.....