


G-6452
47722

T.26S. R.15E., W.M.

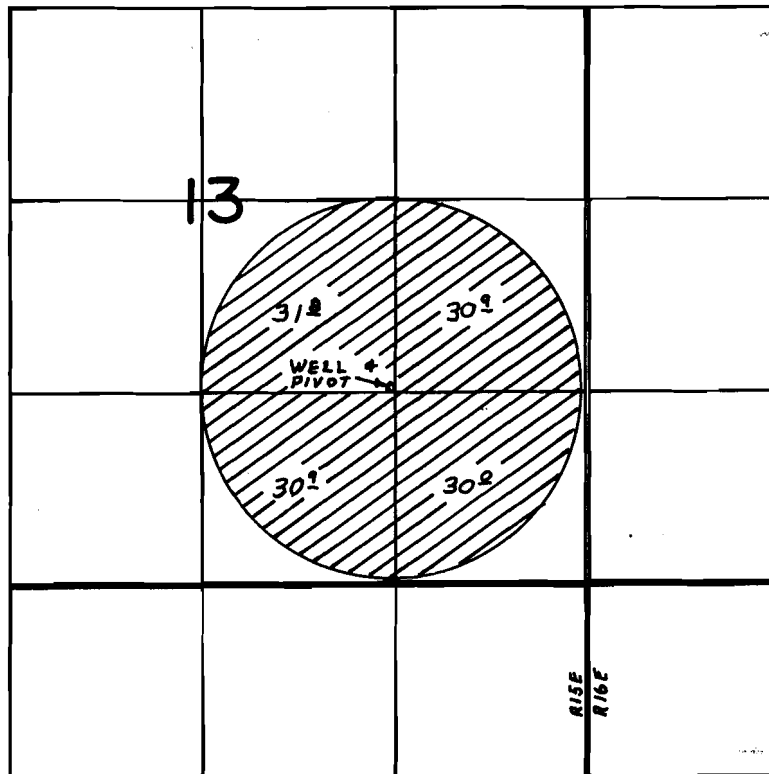

WELL LOC. 1340' N. & 1340' W. FROM S.E. COR. SEC. 13

FINAL PROOF SURVEY
UNDER

Application No. G-6934... Permit No. G-6452..
IN NAME OF

.....DOWERS FARMS INC.

Surveyed JUL 18, 1977, by D.M. NORBY.....