


G-6453

47723

T.26S. R.15E., W.M.

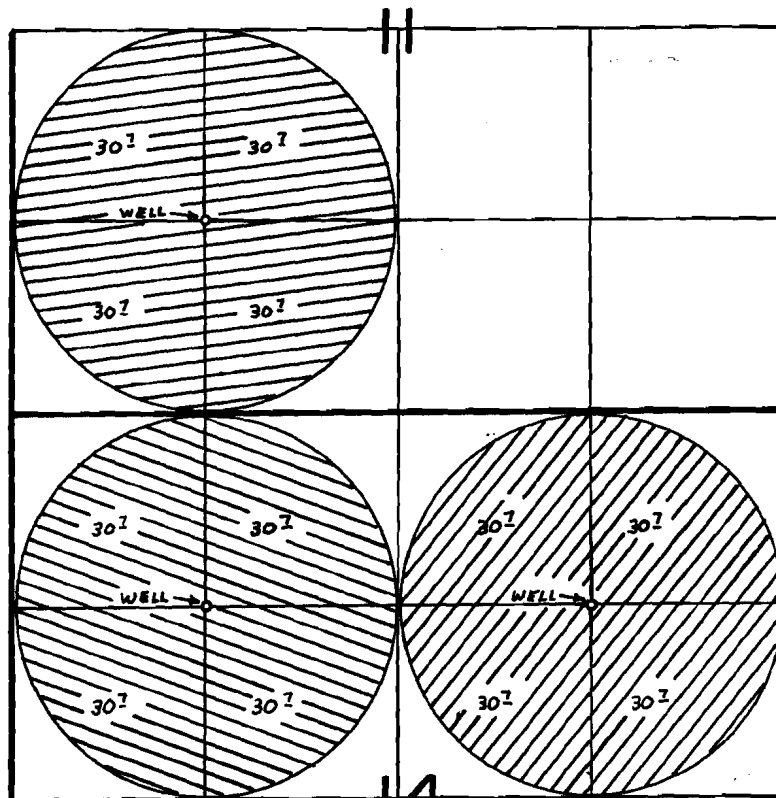

-  APPL G-6932; WELL LOC. 1320' N. & 1320' E. FROM S.W. COR. SEC. 11
 APPL G-6935; WELL LOC. 1320' S. & 1330' E. FROM N.W. COR. SEC. 14
 APPL G-6933; WELL LOC. 1330' S. & 1320' W. FROM N.E. COR. SEC. 14

FINAL PROOF SURVEY UNDER

G-6932

G-6450

G-6933

G-6451

Application No. G-6935 Permit No. G-6453
IN NAME OF

.....DOWERS FARMS, INC.

Surveyed JUL 18, 1977, by D.M. NORBY.....