


G-6820
47724

T.26S. R.15E., W.M.

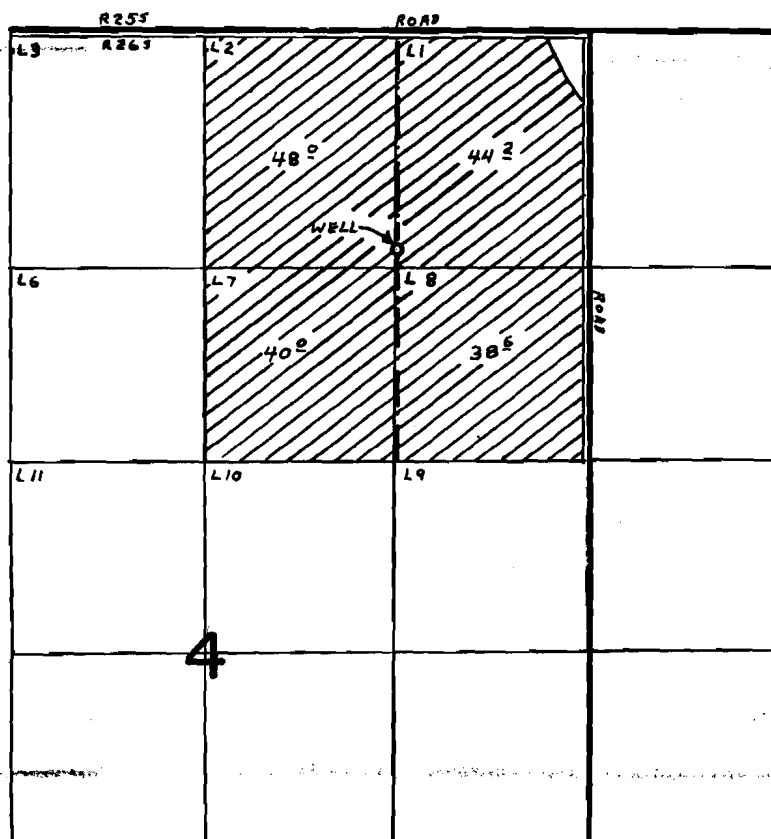

WELL LOC. 1500' S + 1320' W. FROM N.E. COR. SEC. 4

**FINAL PROOF SURVEY
UNDER**

Application No. G-7372. Permit No. G-6820...
IN NAME OF

FRITZ L. & MARILYN R. MORRISON

Surveyed JUL 16, 1977, by D.M. NORBY.....