


T.18S. R.7W. W.M.

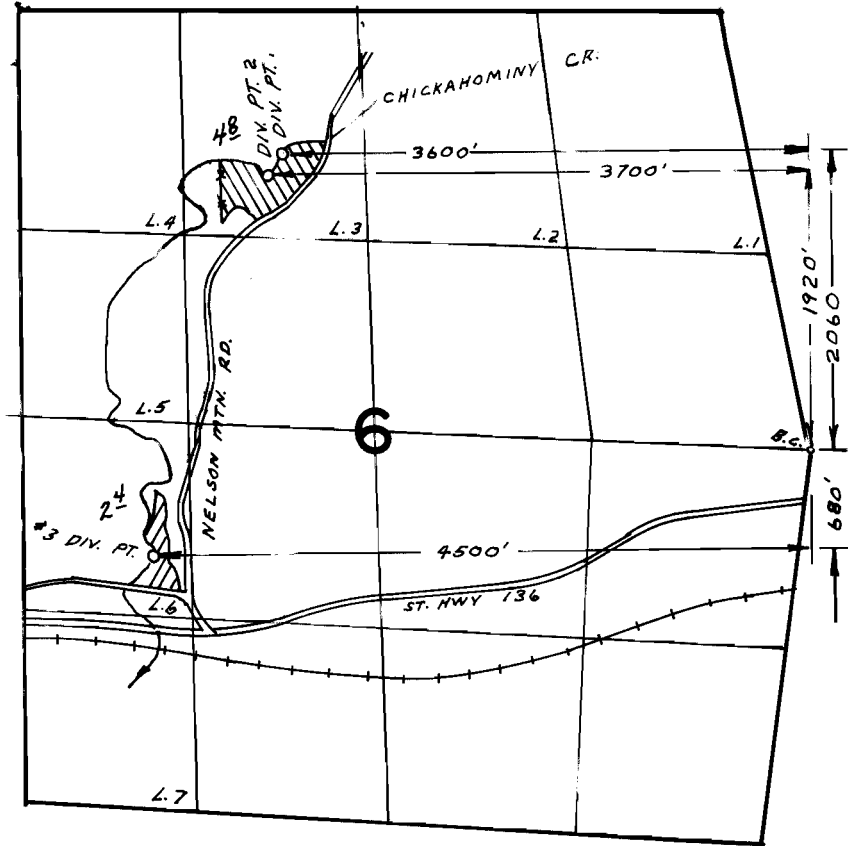

**FINAL PROOF SURVEY**  
UNDER

Application No. 44701 Permit No. 33468  
IN NAME OF

H. & L. RENO - A. & V. PETERSEN

Surveyed MAY 5 1976, by L.H. NUNN