


T.16S.,R.4E.,W.M.

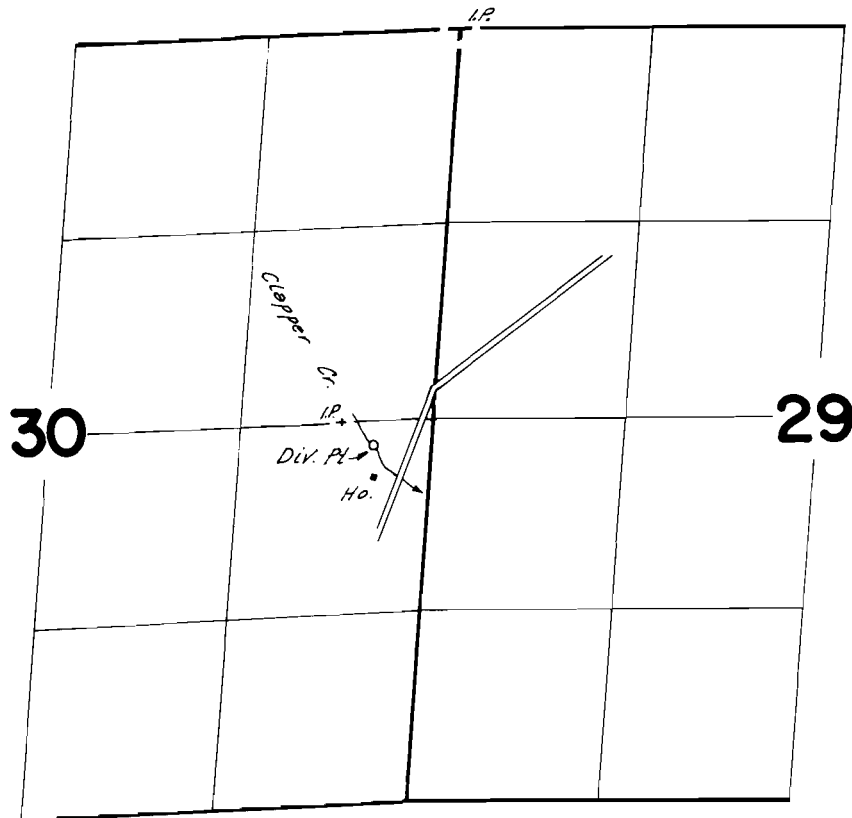

DIV. PT. LOC.: 200' S. & 400' W. from E. $\frac{1}{4}$ cor. Sec. 30

FINAL PROOF SURVEY
UNDER

Application No. 46360 Permit No. 34631
IN NAME OF

Myron L. Bedow

Surveyed May 25, 1976 by D. M. Norby

PTS-1976-B *dlb*