


T.16S. R.8 W. W.M.

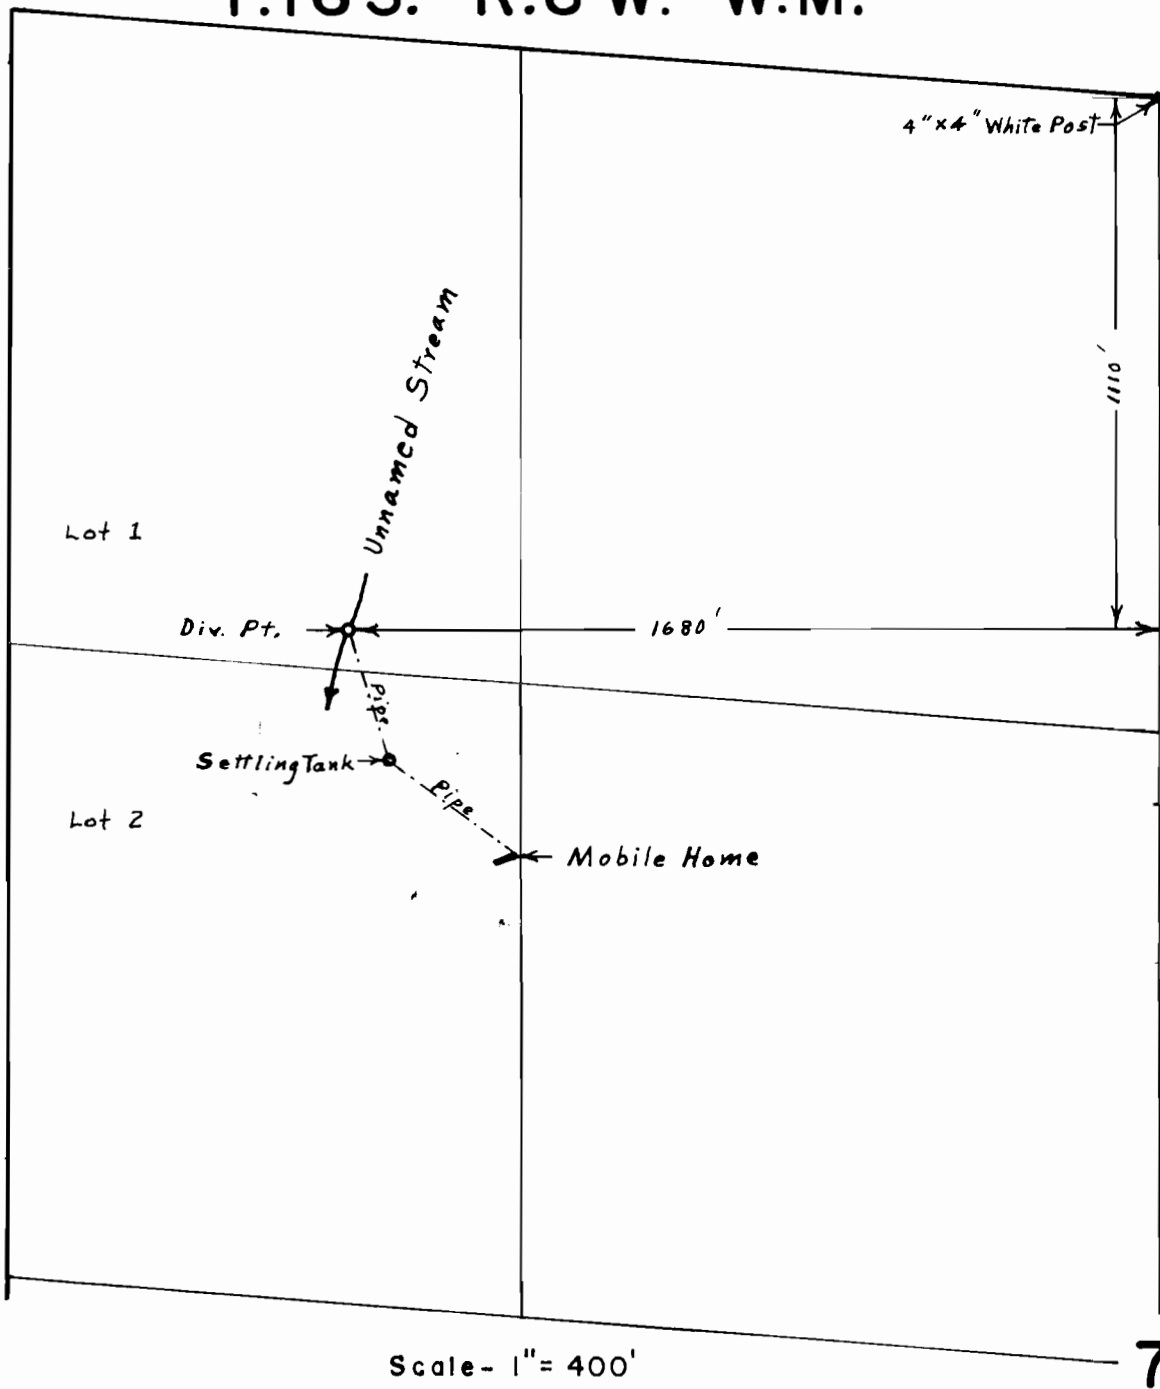

Scale - 1" = 400'

FINAL PROOF SURVEY
UNDER

Application No. 46511 Permit No. 34751
IN NAME OF

Robert E. Nable

Surveyed Aug. 3, 1976, by L. E. Gould.