


T.16S.,R.2E.,W.M.

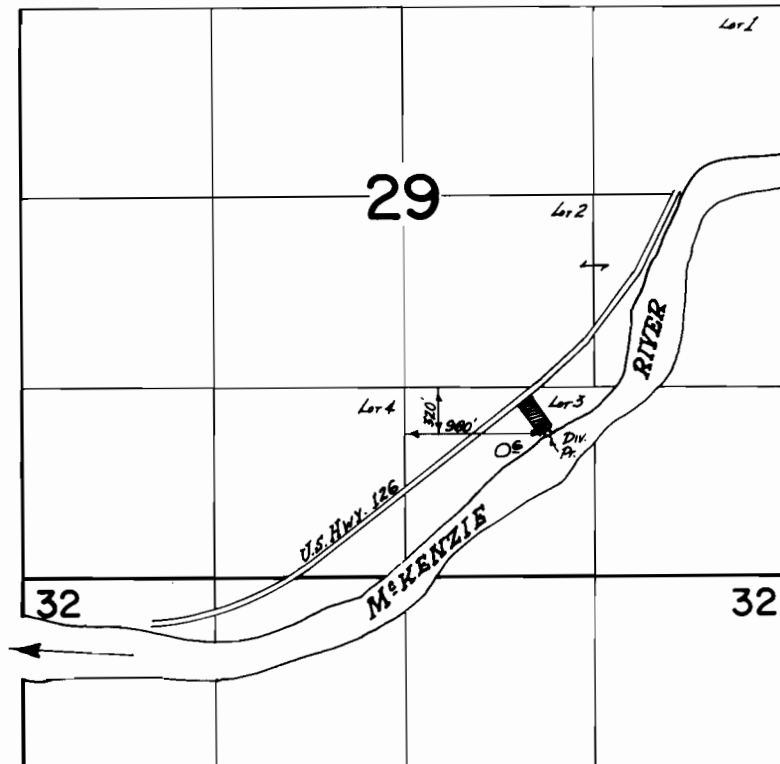

FINAL PROOF SURVEY
UNDER

Application No. 51069 Permit No. 38533
IN NAME OF

Wm. E. & HELENA COPE

Surveyed Aug. 19 1977, by L.M. Toll