


T.19S. R.12W., W.M.

SE SE SEC 14

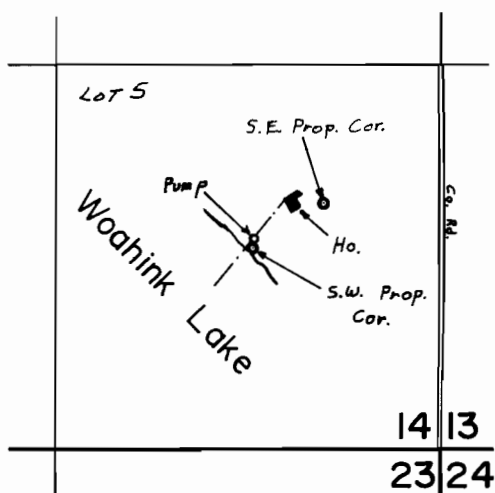

Div. Pt. Loc. 690' N. & 675' W. From S.E. Cor. Sec. 14

Scale: 1" = 660'

FINAL PROOF SURVEY UNDER

Application No. 54052.. Permit No. 39934..
IN NAME OF

.....JOHN E. ESCH.....

Surveyed AUG. 24. 1977, by B.R. SUND.....