


T.10S. R.1W. W.M.

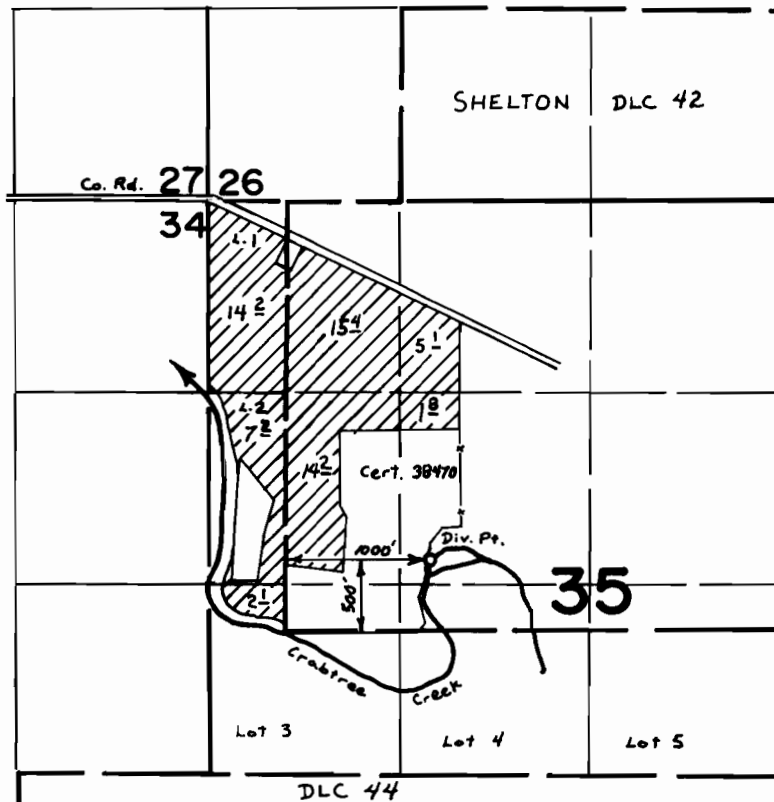

FINAL PROOF SURVEY UNDER

Application No. 49147 Permit No. 36851
IN NAME OF

E.W. and MARY CAWTHORN

Surveyed AUG. 10 1977., by D. NORBY.....