


T.IOS. R.IW. W.M.

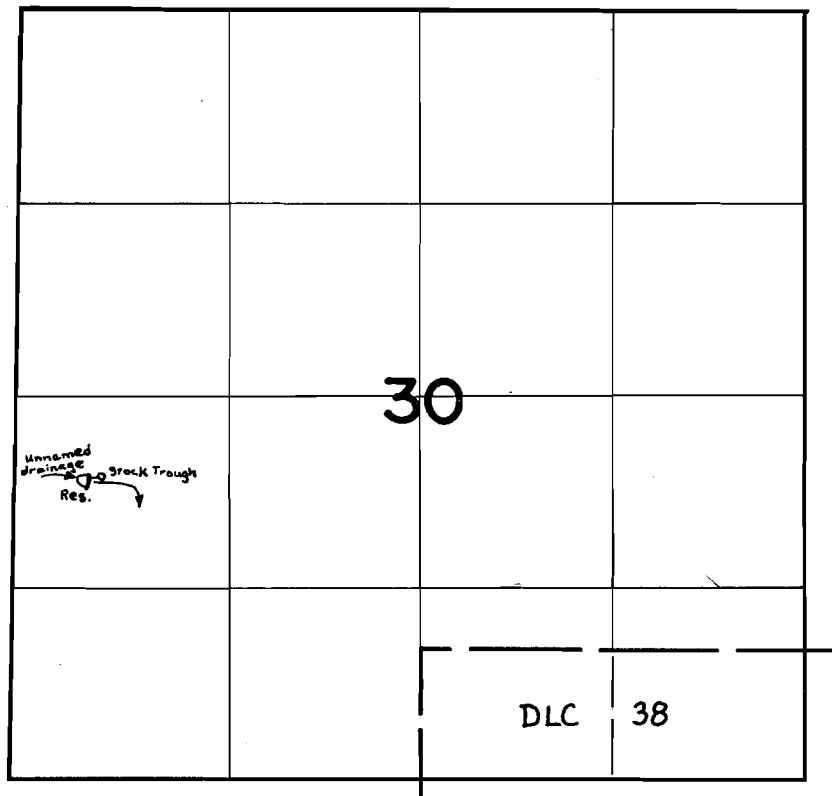

Dam Located: 600'S & 500'E from W $\frac{1}{4}$ cor. Sec. 30

FINAL PROOF SURVEY
UNDER

R-53494 R-6373
Application No. 53495 Permit No. 39620
IN NAME OF

DUANE DRUSHELLA

Surveyed AUG. 11, 1977, by D. NORBY