


T. 18 S.R. 46 E.W.M.

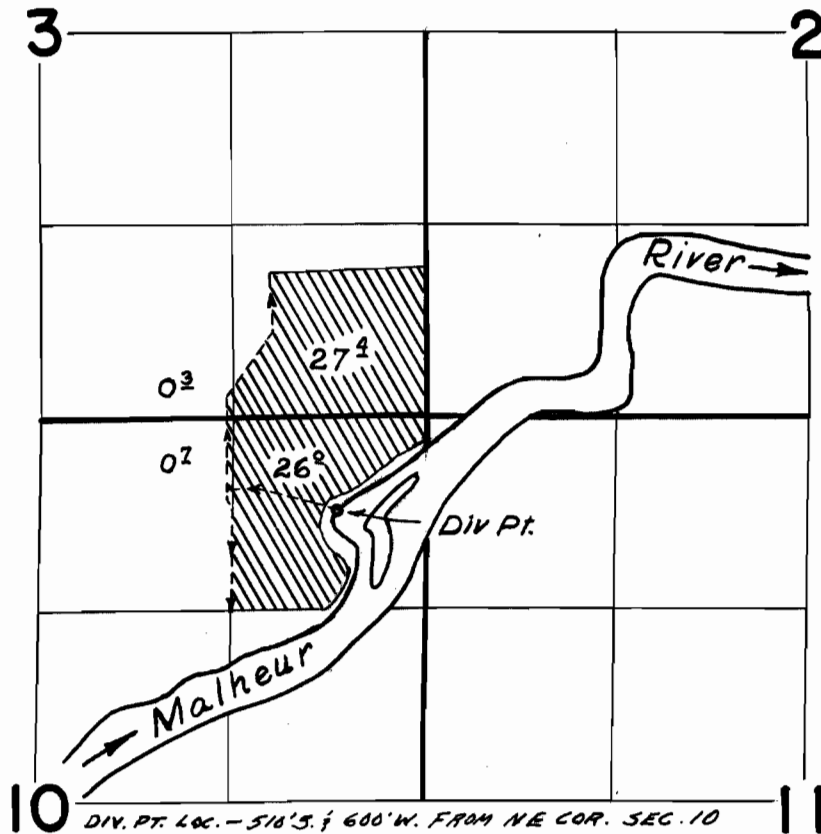

FINAL PROOF SURVEY UNDER

Application No. 32867 Permit No. 26006...
IN NAME OF

JOHN F. & CATHERINE E. JACKSON

Surveyed June 12 1962, by C.R. Baker...
Inspected - Oct. 24, 1978 by B.A. ESTES