


T.6S. R.2W., W.M.

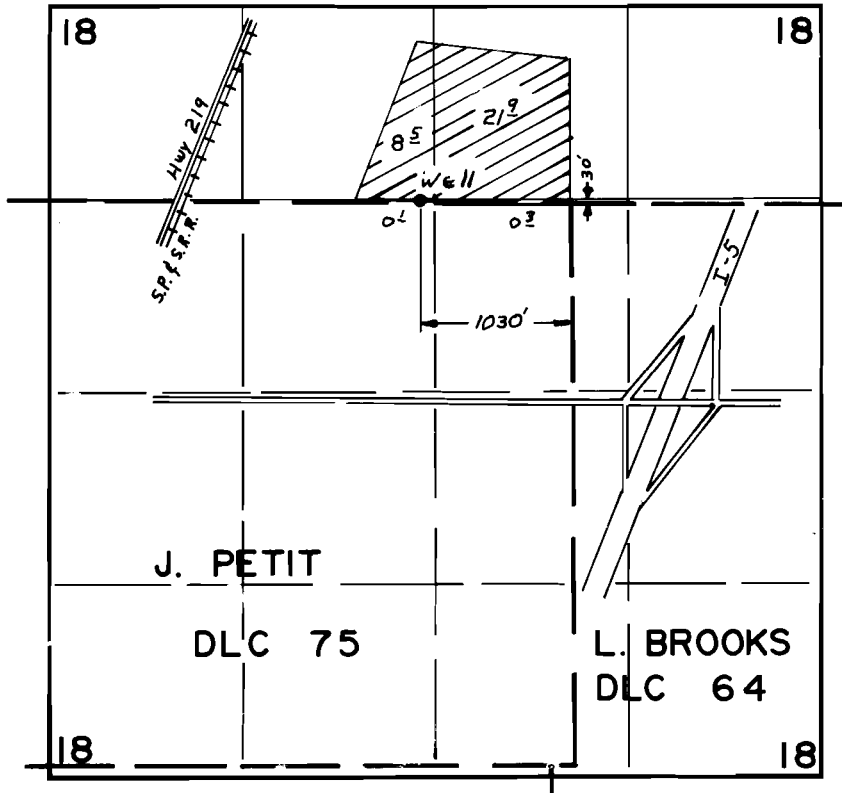

FINAL PROOF SURVEY UNDER

Application No. G-5395. Permit No. G-5321.
IN NAME OF

..... MARY E. PETZEL

Surveyed O.C.T. 10. 1978., by J.S. DONALDSON