


T.9S. R.1W., W.M.

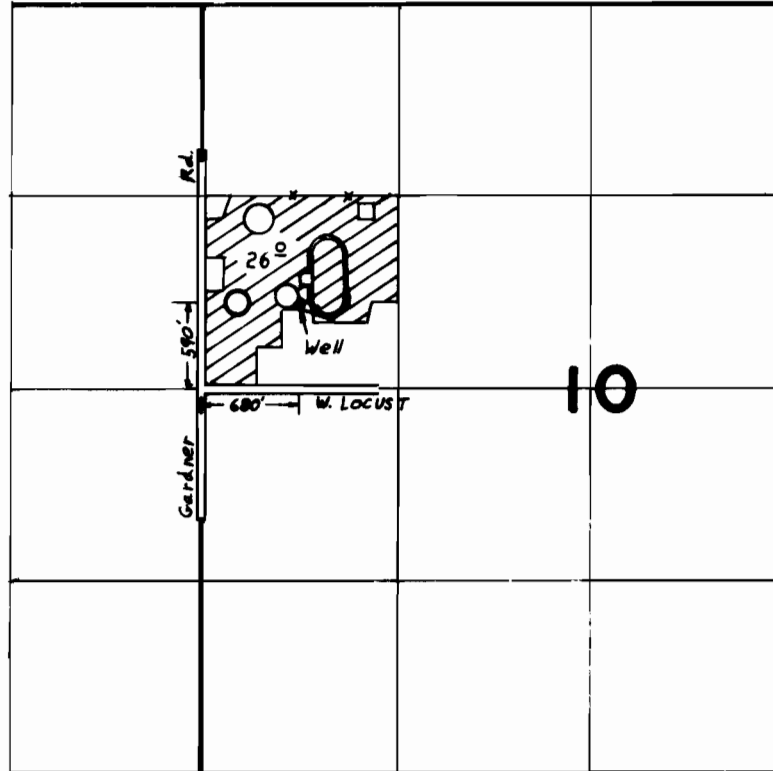

FINAL PROOF SURVEY UNDER

Application No. G-6265. Permit No. G-5901...
IN NAME OF

STAYTON UNION HIGH SCHOOL DIST. UH4J

Surveyed SEPT. 14, 1977, by B.R. SUND.....