
T. 6 7S. R. I 2W. W.M.

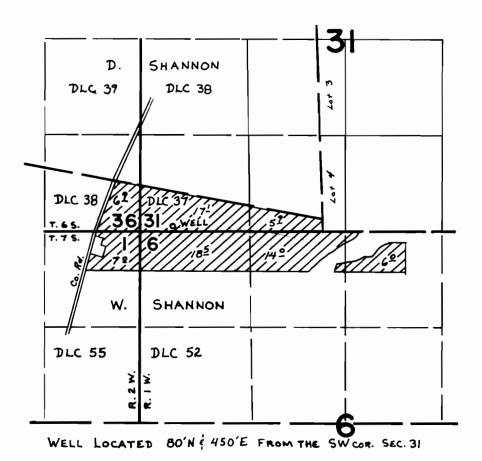

FINAL PROOF SURVEY

Application No. G-6399 Permit No. G-5988 IN NAME OF
CLARENCE D. HERR
Surveyed SEPT. 7 1977 by D. NORBY