


T.4S. R.IW., W.M

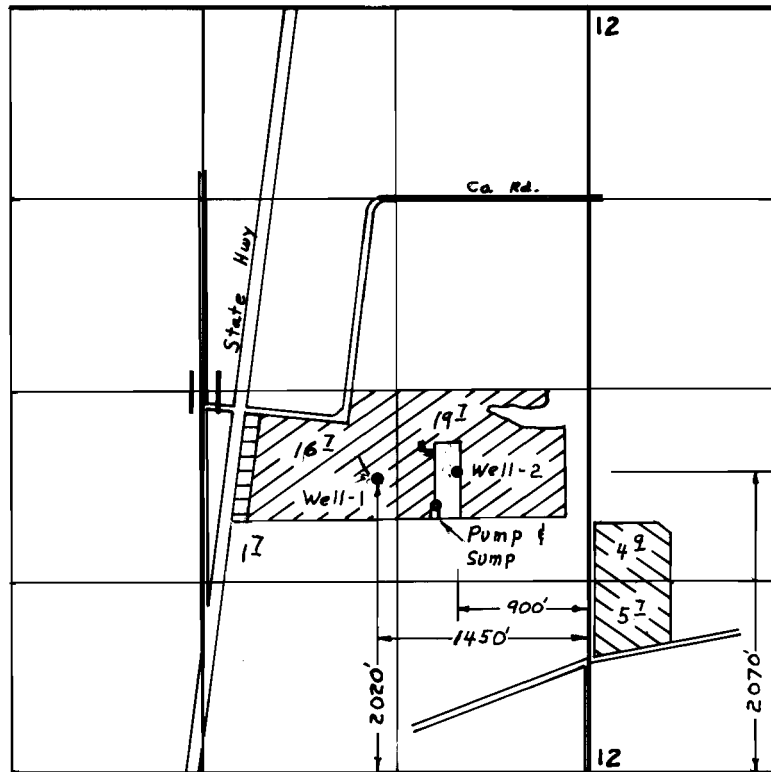

App'l. G-6881 primary supp'l.
 App'l. G-8109

FINAL PROOF SURVEY UNDER

G-6881 G-6413
 Application No. ~~G-8109~~ Permit No. ~~G-7491~~
 IN NAME OF

.....RICHARD P. JENKS.....

Surveyed AUG. 19, 1977, by B. R. SUND.....
 AUG 15, 1978 J. S. DONALDSON