


# T. 6 S. R. 1 W. W. M.

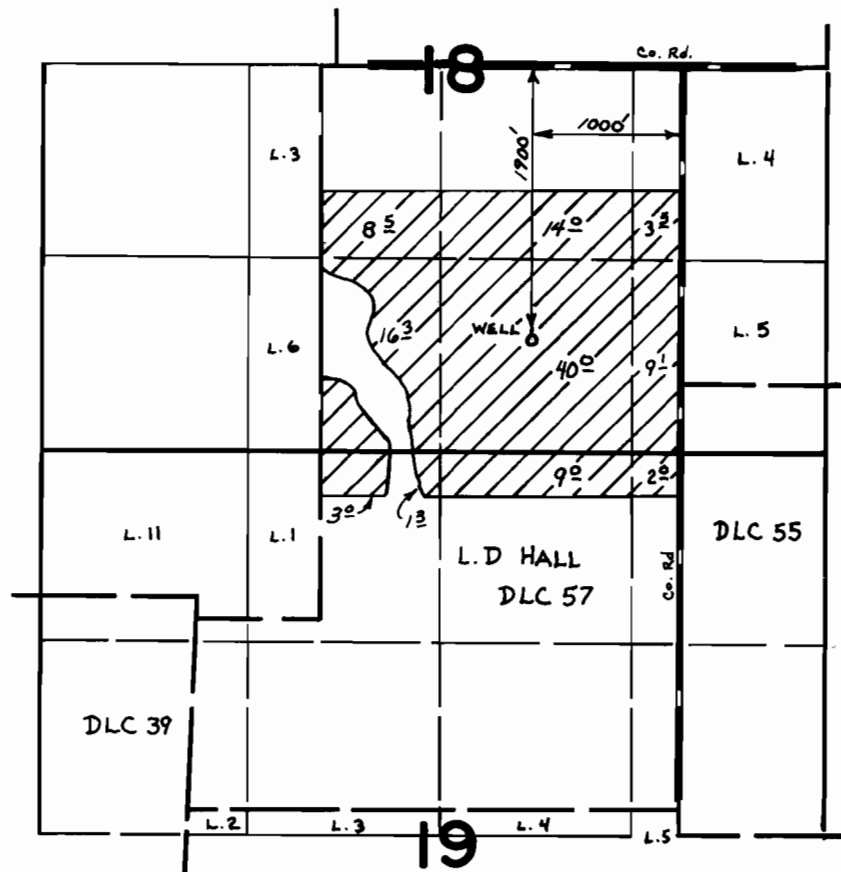

## FINAL PROOF SURVEY UNDER

Application No. G-7038 Permit No. G-6525  
IN NAME OF

JOSEPH J. ERPELDING

Surveyed Sept. 6 1977, by D. NORBY