T. 4 S. R. 1 W., W.M

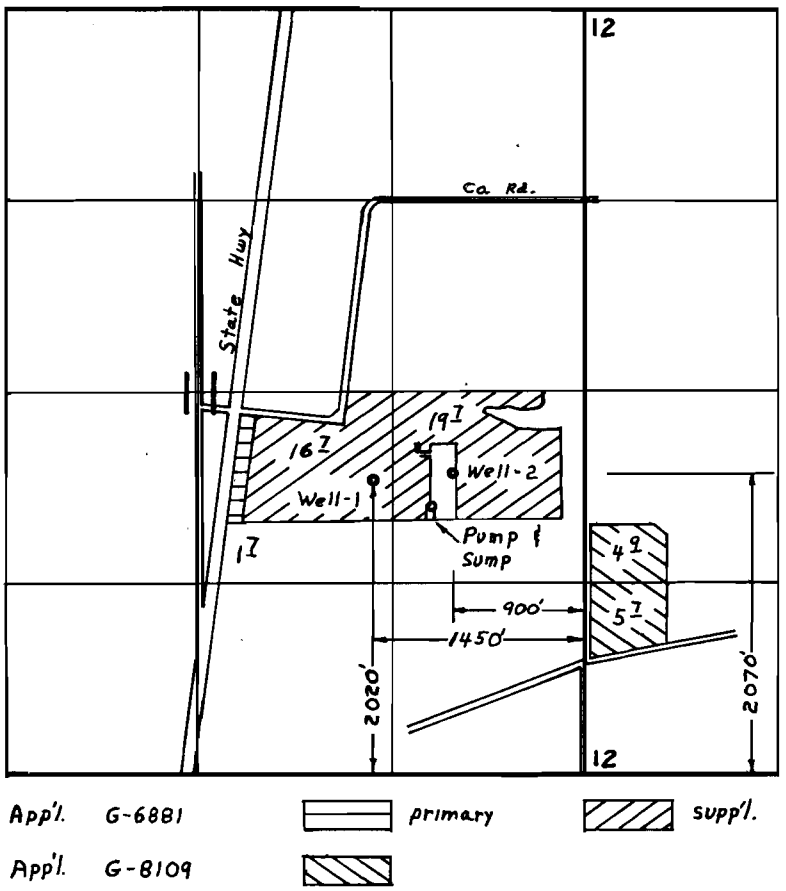

FINAL PROOF SURVEY
UNDER

G-6881 G-6413
Application No. G-8109 Permit No. G-7491
IN NAME OF

RICHARD P. JENKS

Surveyed AUG 19 1977, by B. R. SUND
AUG 15, 1978 J. S. DONALDSON

V-3LL-164 & 1977-14-A