


T.1S.,R.4E.,W.M.

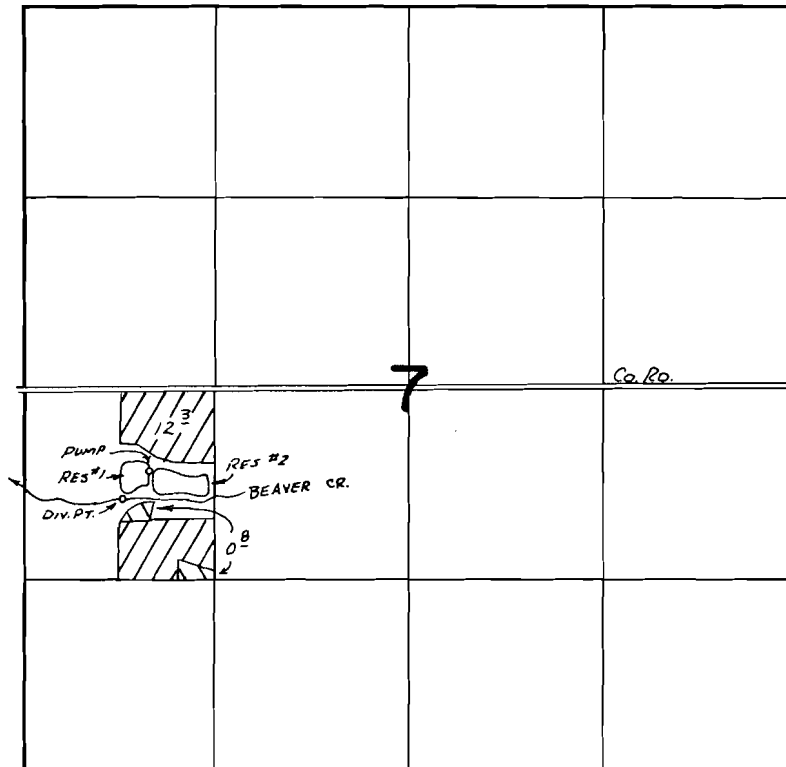

DIV. LOTS: STR. - 750'S AND 670'E; RES #1 - 600'S AND 660'E; RES #2 - 600'S AND 880'E - ALL FROM W 1/4 COR SEC 7

FINAL PROOF SURVEY
UNDER

R-40685 R-4543
Application No. 40686 Permit No. 30250
IN NAME OF

ERLING H. & PATRICIA E. JONES

Surveyed JUNE 9, 1976, by L. T. S.