


T.6S.,R.4W.,W.M.

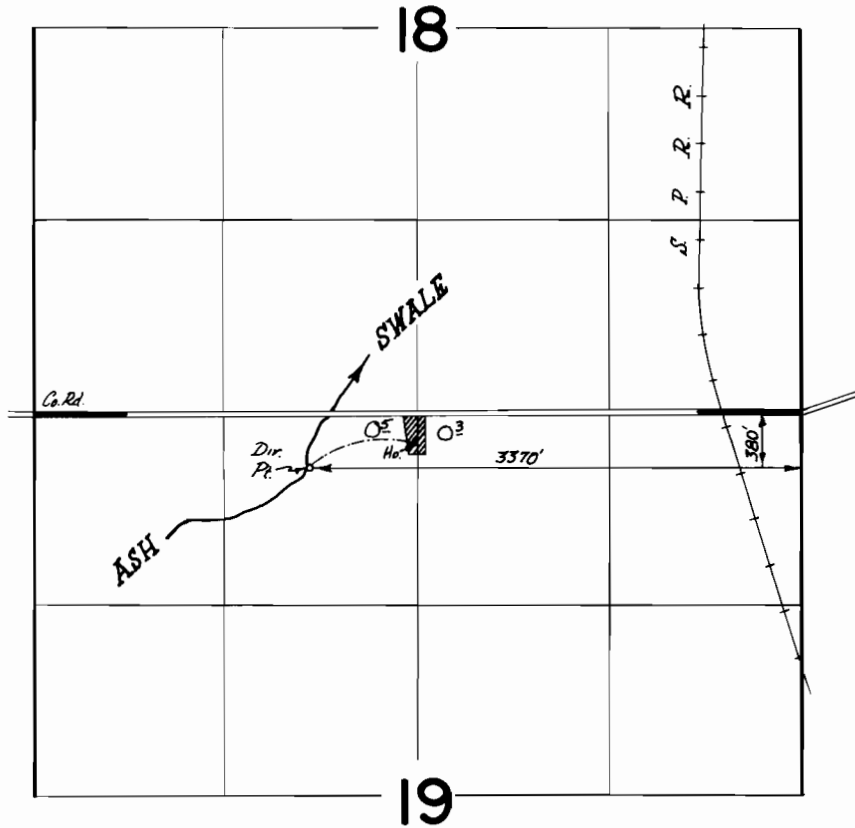

FINAL PROOF SURVEY UNDER

Application No. 53019 Permit No. 40310
IN NAME OF

VERNON L. & MARIE MAXON

Surveyed Aug. 10, 1977, by L.M. Toll