


T.7S.,R.5W.,WM.

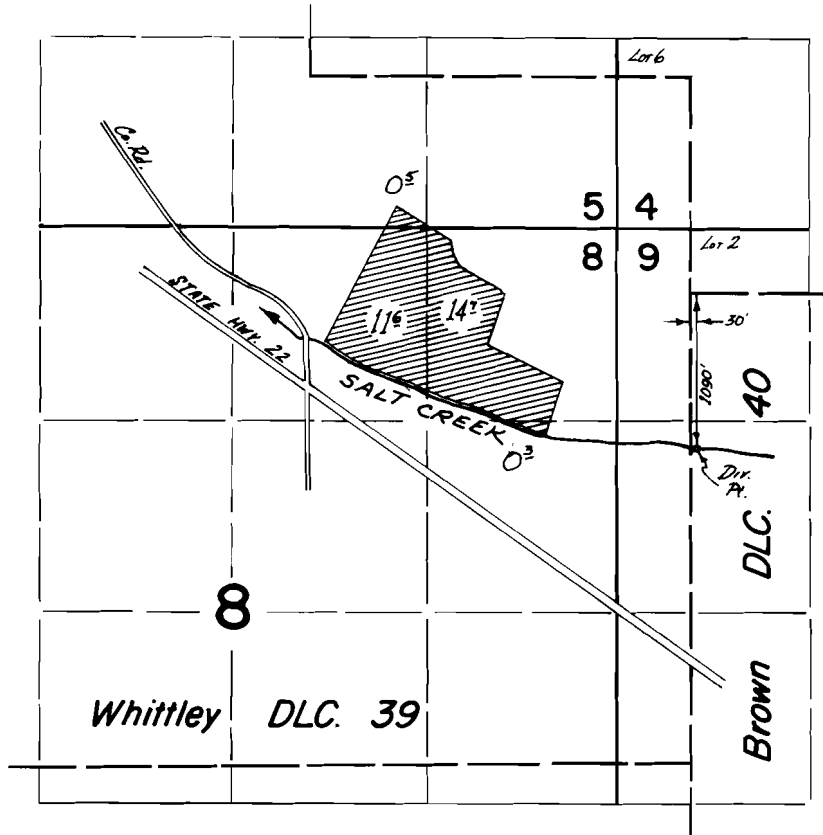

FINAL PROOF SURVEY
UNDER

Application No. 54159 Permit No. 40544
IN NAME OF

DONALD HOEKSTRE

Surveyed July 7 1977, by L.M. Tom