


T.6S.,R.6W.,W.M.

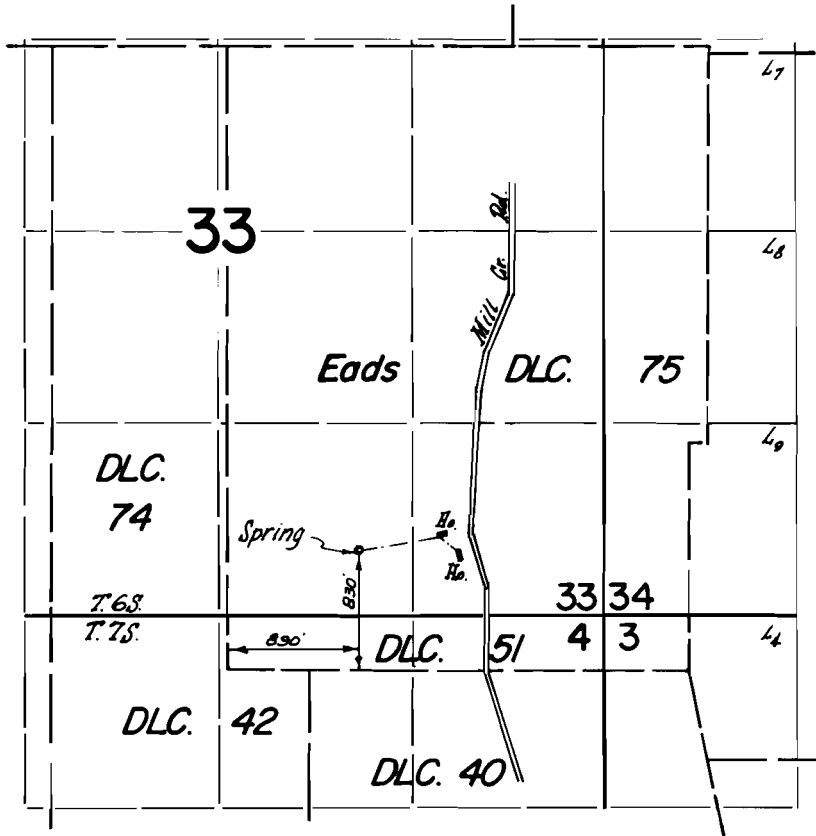

FINAL PROOF SURVEY UNDER

Application No. 54306 Permit No. 40663
IN NAME OF

GARY A. HAMPTON

Surveyed Aug. 10 1977, by L.M. Tom