


T.6S.R.6W. WM

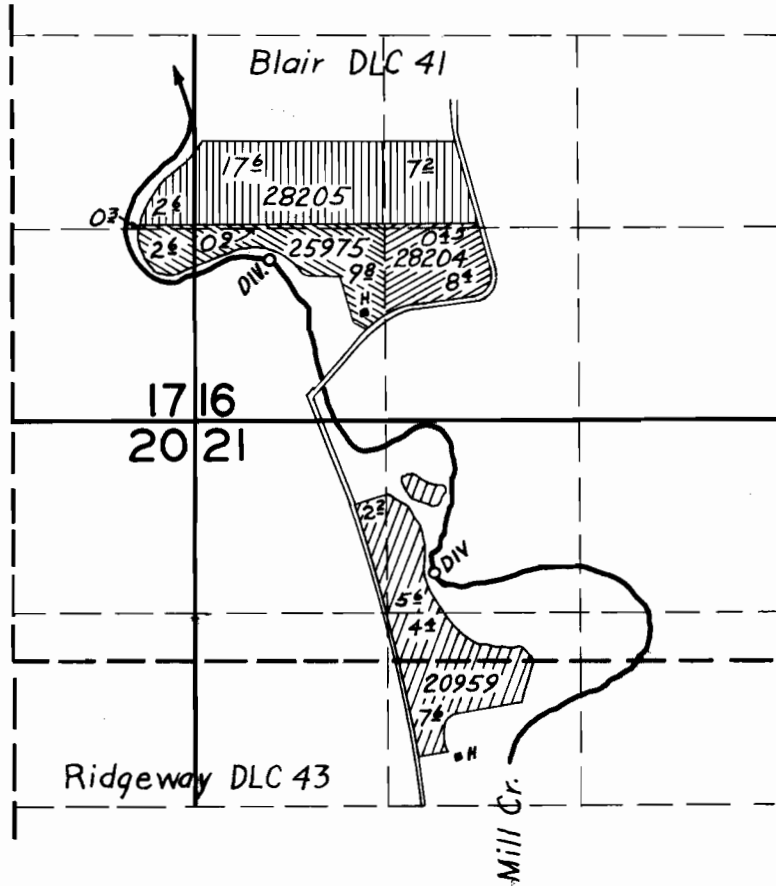

FINAL PROOF SURVEY

	20958	16406
	28205	22193
	28204	22192
Application No.	25975	Permit No. 20357
	Gerald R. Allen	
	Otto Debrick	
	Dan O. Blair	
	Dan O. Blair	

Surveyed July 12 19 54, by T. Jones