


T.6 S.R.6 W.W.M.

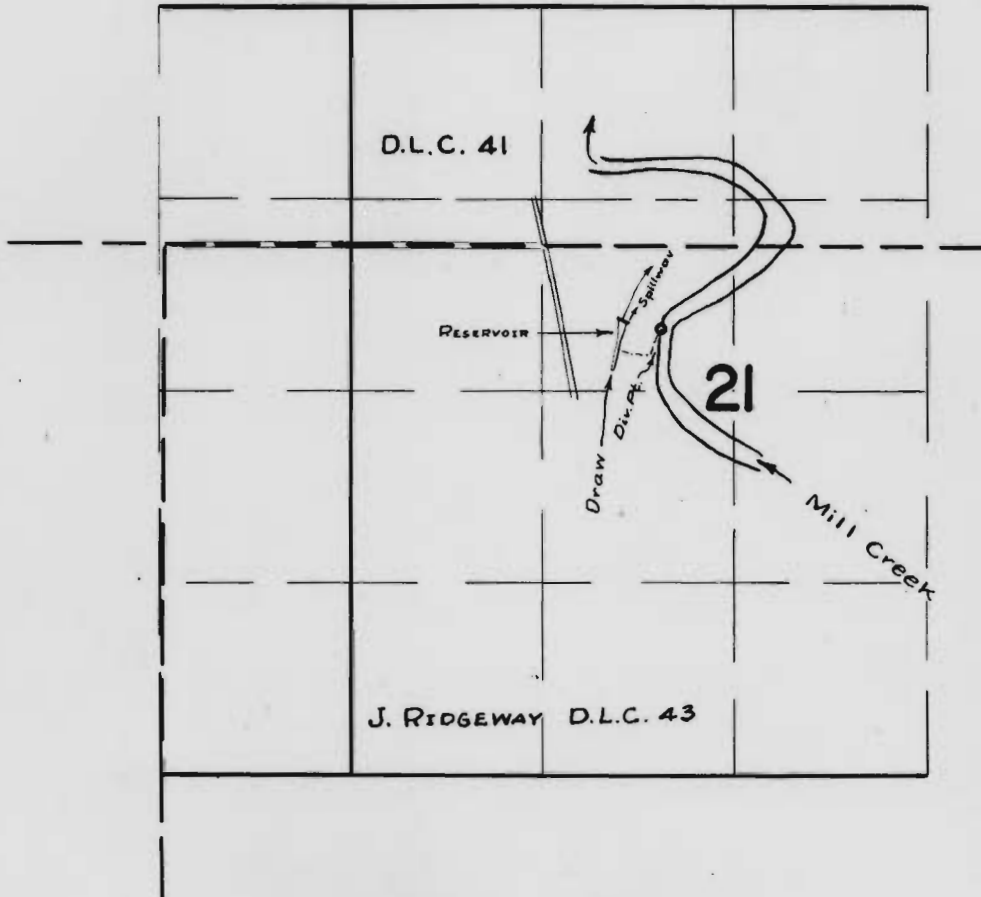

FINAL PROOF SURVEY UNDER

Application No. *P-31884* 31885 Permit No. *P-2075* 25131
IN NAME OF

WM. P. HARRIS

Surveyed 28 JULY 1961, by *m. Bish*