


T. 6S. R. 6W. W.M.

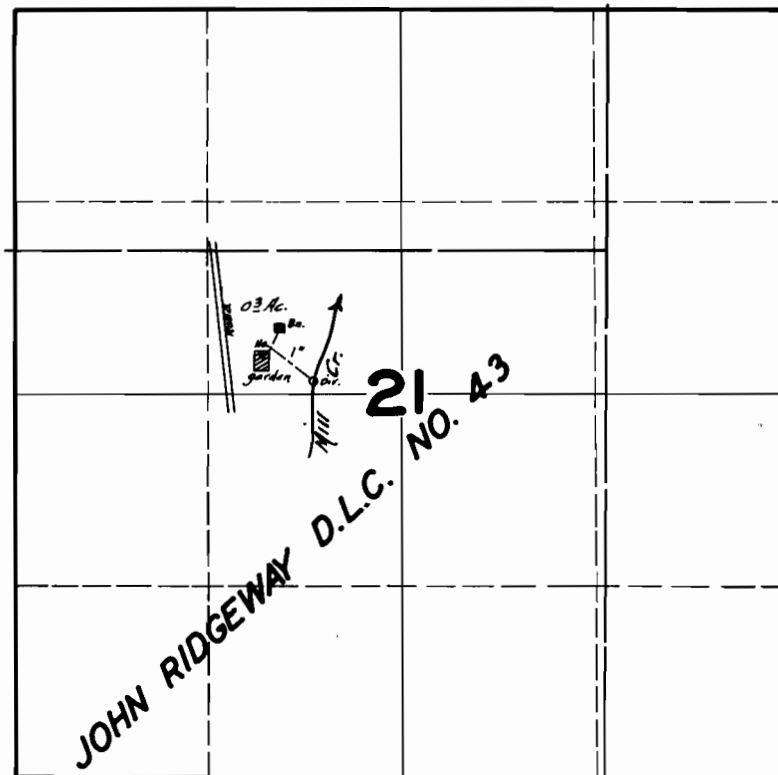

FINAL PROOF SURVEY

UNDER

Application No. 19959 Permit No. 15530

IN NAME OF

LIZZIE L. EVANS

Surveyed JUNE 8 1945