


T.1N. R.16E. W.M.

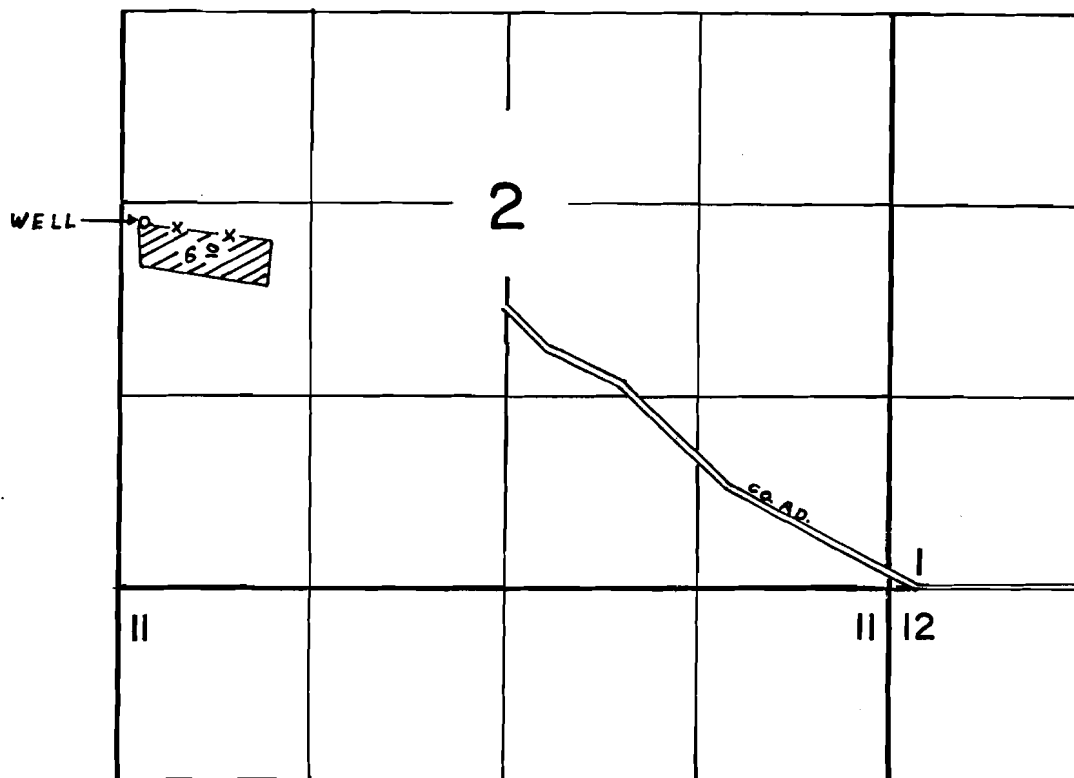

WELL LOC. 130'S. + 150'E. FROM W. 1/4 COR. SEC. 2

FINAL PROOF SURVEY UNDER

Application No. G-5517 Permit No. G-5407
IN NAME OF

PAULEN W. KASEBERG

Surveyed OCT. 27, 1977, by R. G. MUCKEN