


# 37499

T.2N.R.12E.W.M.

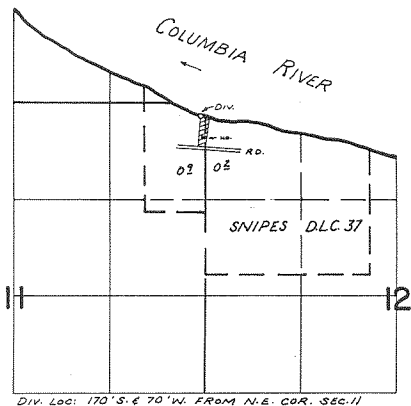

FINAL PROOF SURVEY  
UNDER

Application No. 50731 Permit No. 37499  
IN NAME OF

.....  
EARL SMART  
.....

Surveyed APR. 6 1976, by R. MUGLEN

1976-Z