


T.2N.R.2W.W.M.

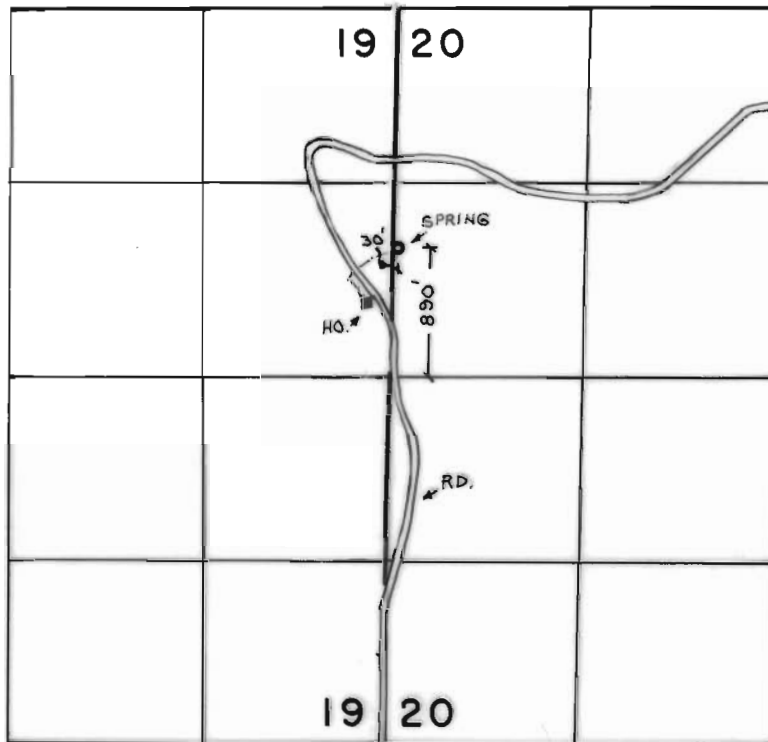

FINAL PROOF SURVEY
UNDER

Application No. 50847 Permit No. 38391
IN NAME OF
LARRY CLAY & CLAY O. DORLAND

Surveyed May 21, 1976, by R.G. Mucken.