


7-34599

T.10S., R.23E., W.M.

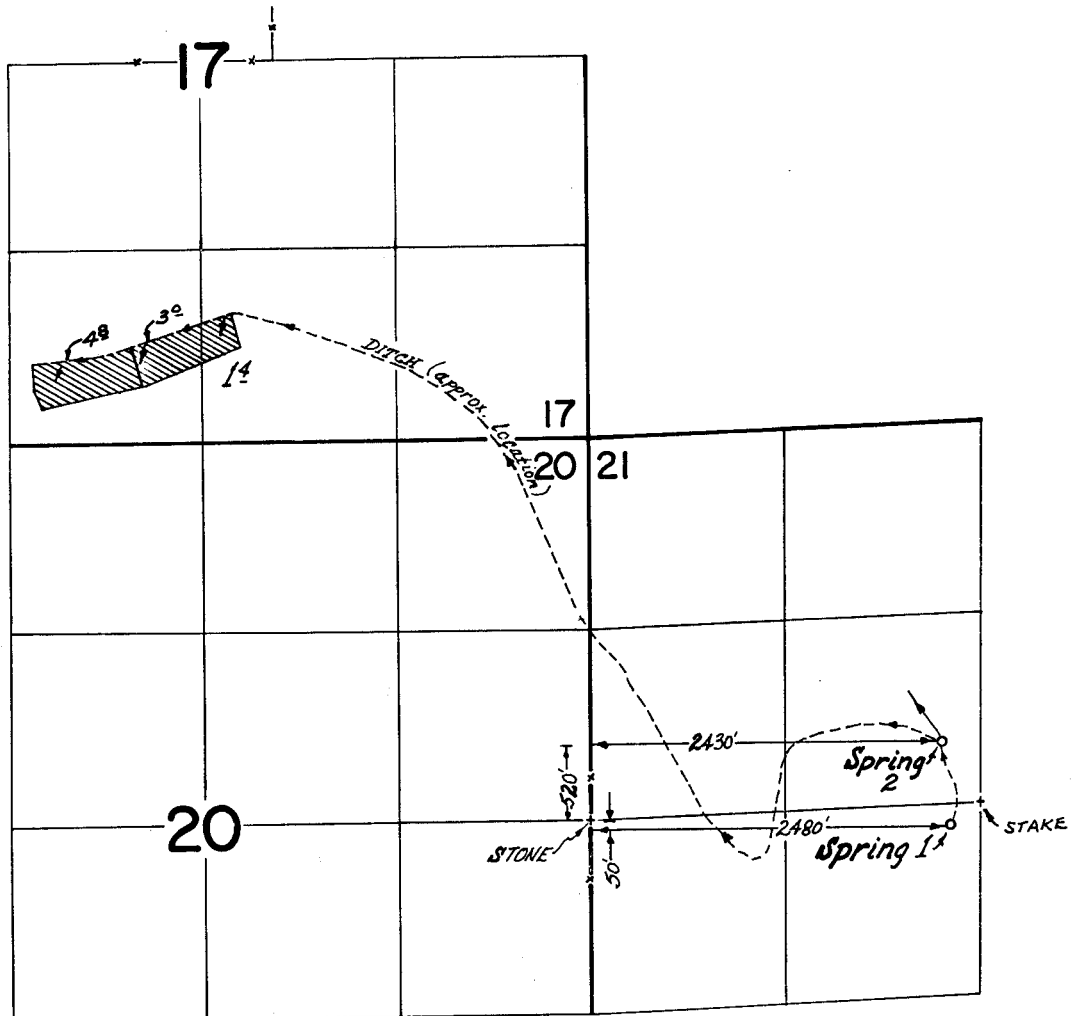

FINAL PROOF SURVEY
UNDER

Application No. 46684 Permit No. 34599
IN NAME OF

CENTRAL OREGON FABRICATORS, INC.

Surveyed Aug. 29 1977, by R.G. Mucken

1977-Z *AR*