


T.3&4S. R.3W. W.M.

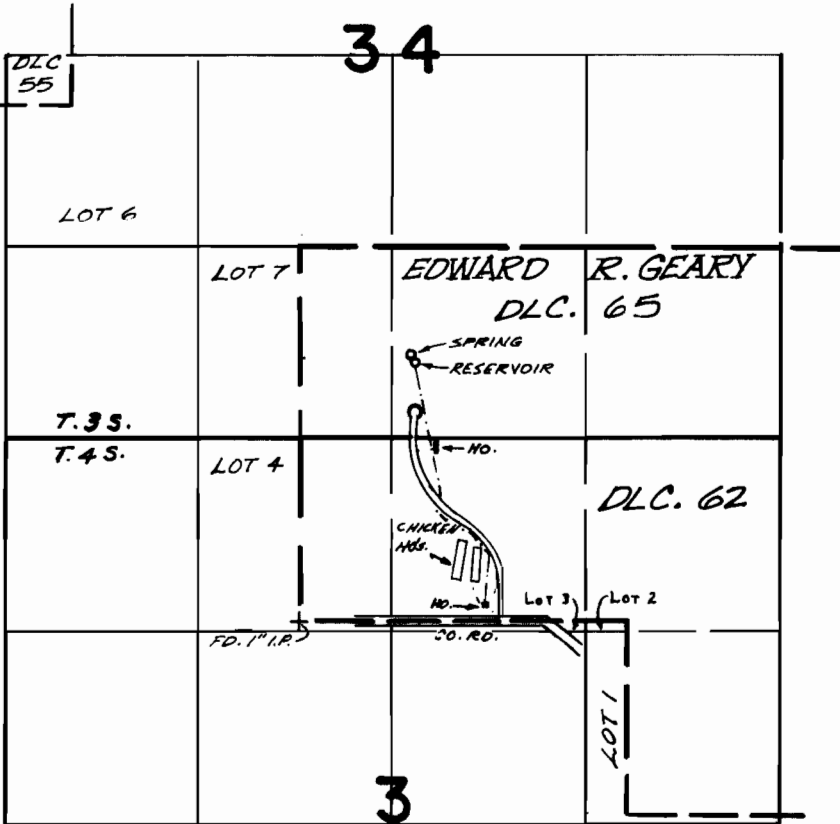

SPR. Loc: 1840' N & 750' E from WESTERLY S.W. COR. DLC. 62

### FINAL PROOF SURVEY UNDER

Application No. 46548 Permit No. 34774  
IN NAME OF

JOHN C. DIXON, JR. & RETA A. DIXON

Surveyed JUNE 14 1974, by L.M. TOLL