


T.IIS.,R.6W.,W.M.

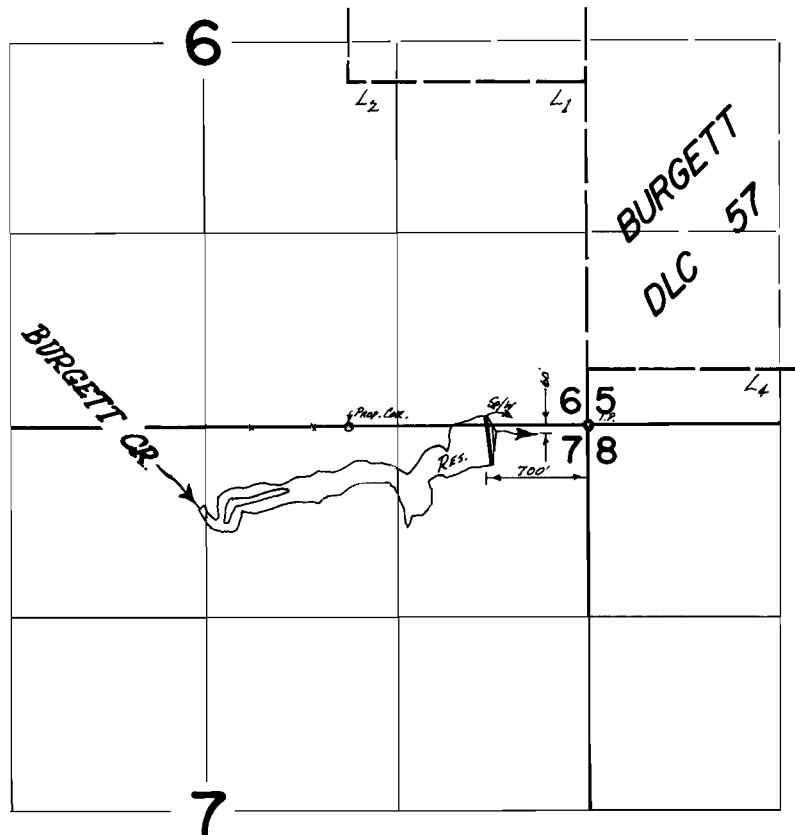

# FINAL PROOF SURVEY

## UNDER

R-48980 R-5807  
Application No. 48981 Permit No. 35933  
IN NAME OF

SANTIAM GIRL SCOUT COUNCIL of OREGON, INC.

Surveyed April 26-7 1977, by L.M. TOLL