


T.11S.,R.6W.,W.M.

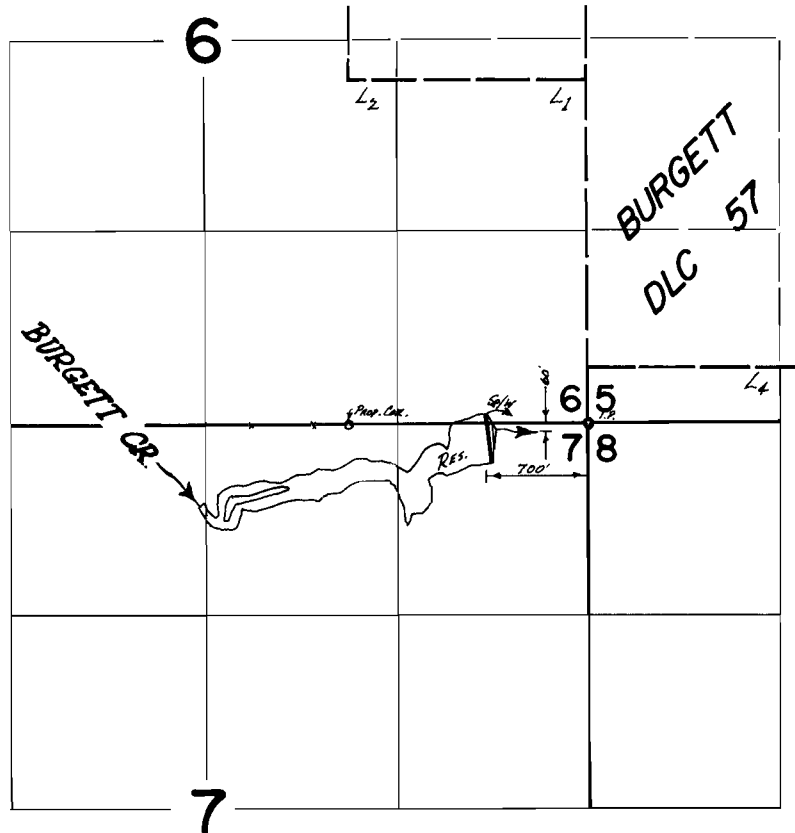

FINAL PROOF SURVEY
UNDER

R-48980

R-5807

Application No. 48981 Permit No. 35933
IN NAME OF

SANTIAM GIRL SCOUT COUNCIL of OREGON, INC.

Surveyed April 26-7 1977, by L.M. TOLL