


T.6N.,R.10W.,W.M.

SEC. 22

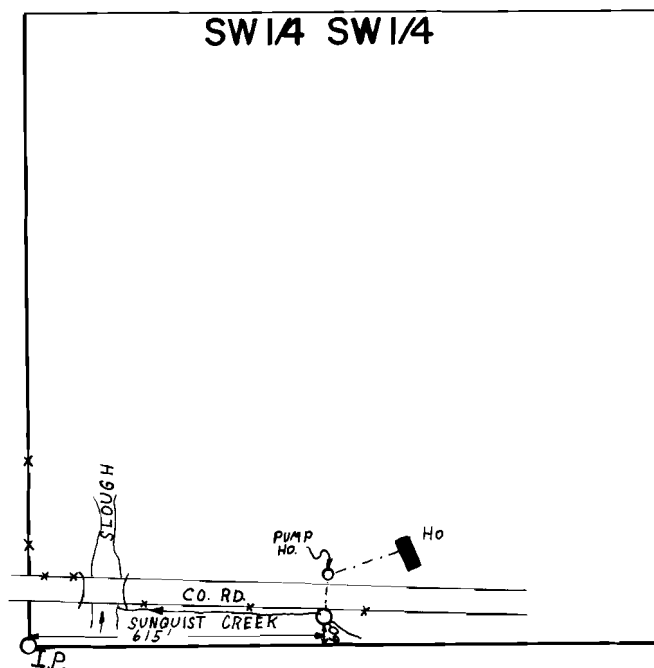

SCALE: 1" = 400'

FINAL PROOF SURVEY
UNDER

Application No. 48453 Permit No. 35258
IN NAME OF

DAVID G. & MARIAN RALL

Surveyed SEPT. 14, 1976, by C.R. KING