


T.32S., R.6W., W.M.

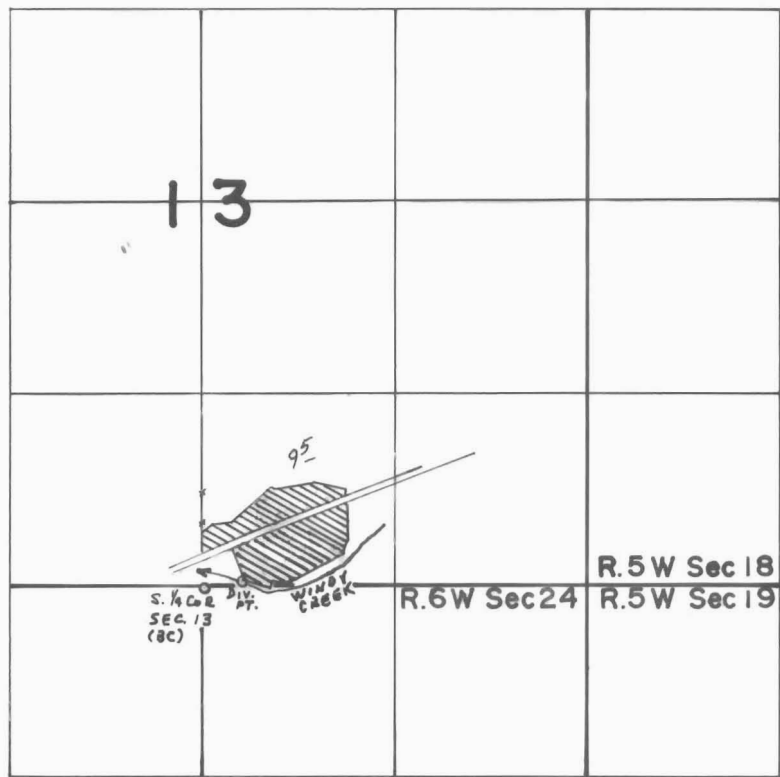

DIV. PT. LOC: 20' N & 250' E. FROM 5/4 COR SEC 13

FINAL PROOF SURVEY UNDER

Application No. 49565... Permit No. 37096.
IN NAME OF

.....GEROME J. RUCKER.....

Surveyed APR. 27. 1977, by D.M. NORBY.....