


T. 33 S. R. 7 W. W.M.

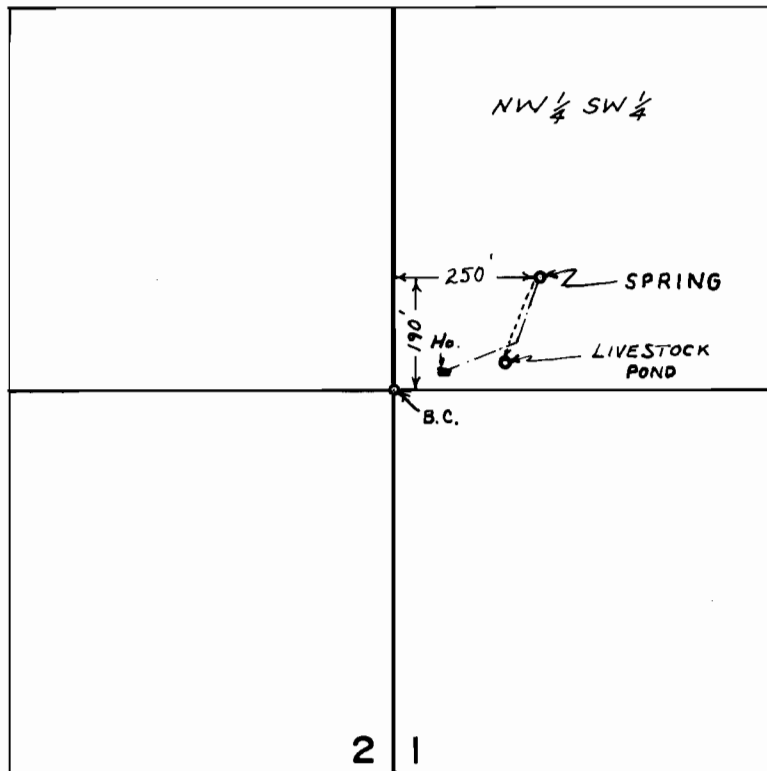

SCALE: 1" = 660'

FINAL PROOF SURVEY
UNDER

Application No. 49862 Permit No. 37493
IN NAME OF

ROY WESLEY & DARLEEN CARYL KAYLOR

Surveyed Apr. 28 1977, by D.M. NORBY