


T.32S.,R.6W.,W.M.

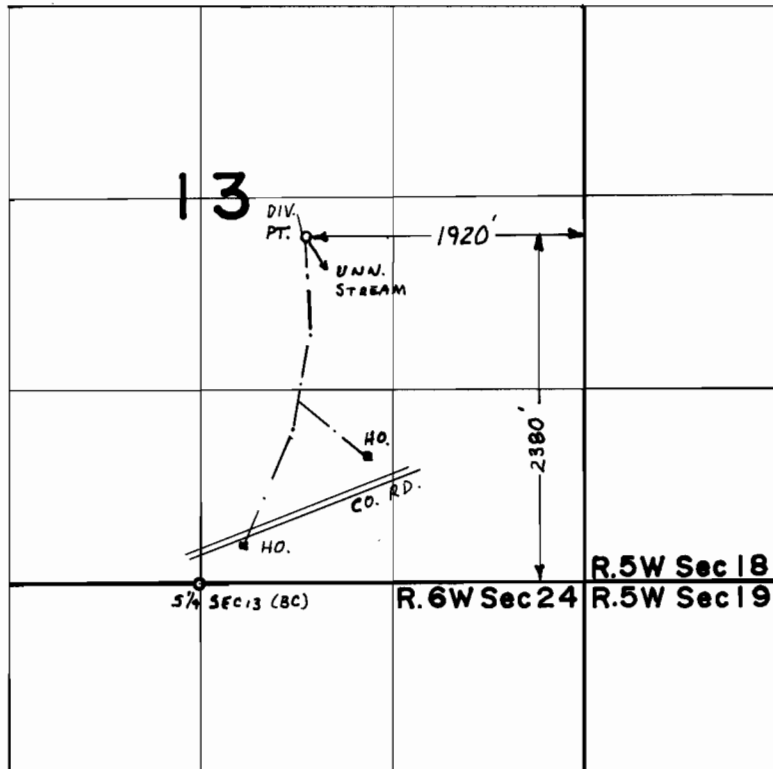

FINAL PROOF SURVEY
UNDER

Application No. 54108 Permit No. 40506
IN NAME OF

IMOGENE L. RUCKER

Surveyed APR. 27 1977, by D.M. NORBY