


T. 30S., R. 4W., W.M.

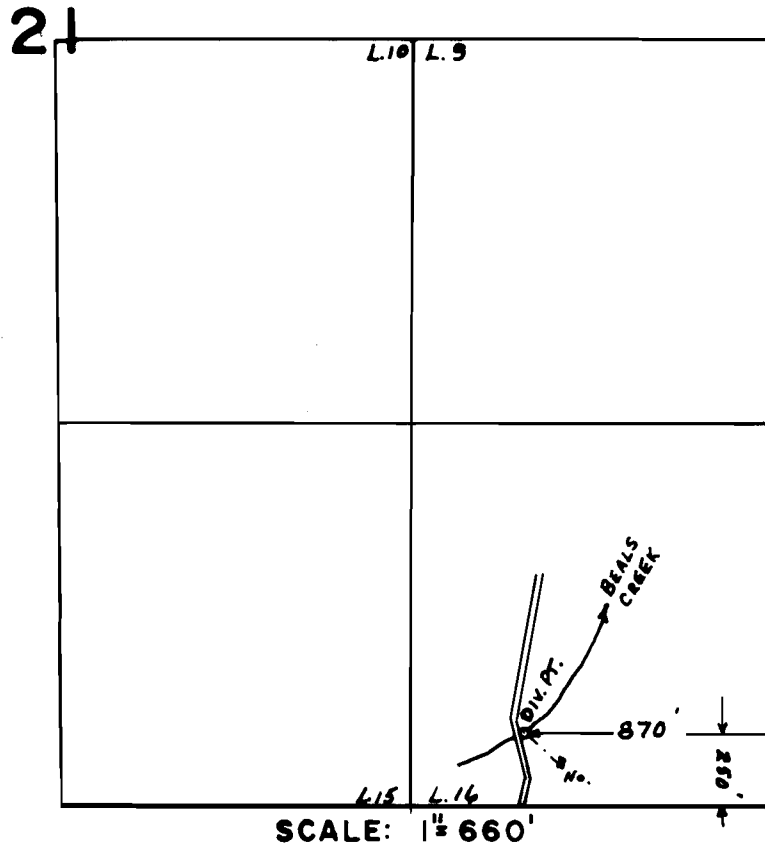

FINAL PROOF SURVEY
UNDER

Application No. 54318 Permit No. 40667
IN NAME OF

RICKY L. HAYTER

Surveyed APR. 26 1977, by D.M. NORBY