


T.26S. R.6&7W. W.M.

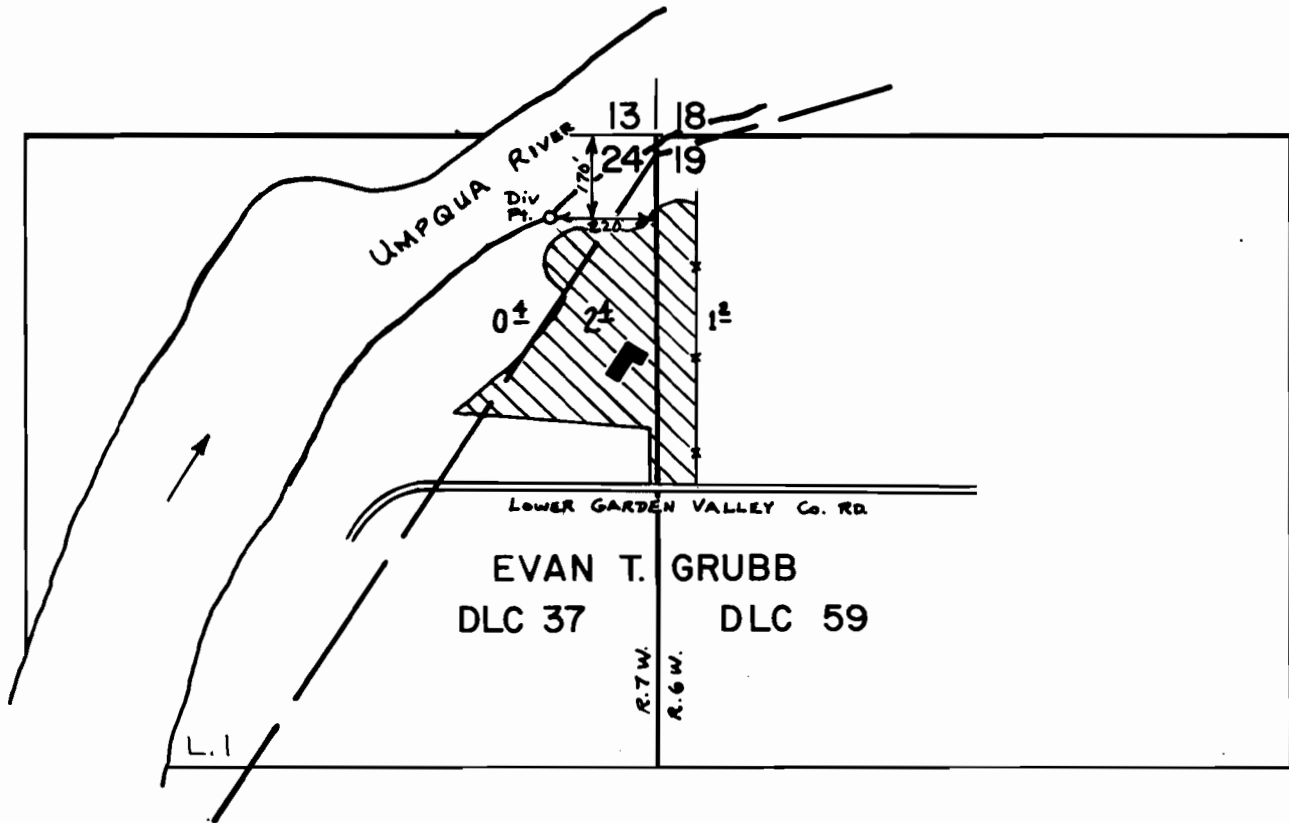

SCALE: 1" = 400'

**FINAL PROOF SURVEY**  
UNDER

Application No. 57661..... Permit No. 43478.  
IN NAME OF

**JOSEPH C. & SHIRLEY B. TOMAN**

Surveyed Dec. 13... 1978, by S. Donaldson.....