


P-36175
47803

T.6S., R.24E., W.M.

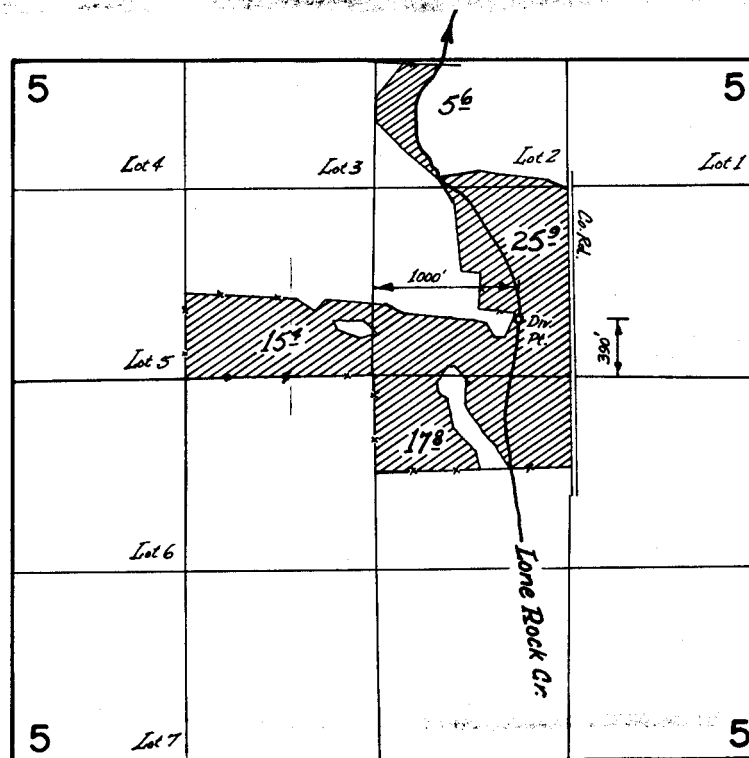

FINAL PROOF SURVEY
UNDER

Application No. 48142... Permit No. 36175...
IN NAME OF

THOMAS W. &/or ELIZABETH G. WELBORN

Surveyed Aug. 26... 1977, by R.G. Mucken.....