


P-36706
C-47804

T.13S.R.31E.W.M.

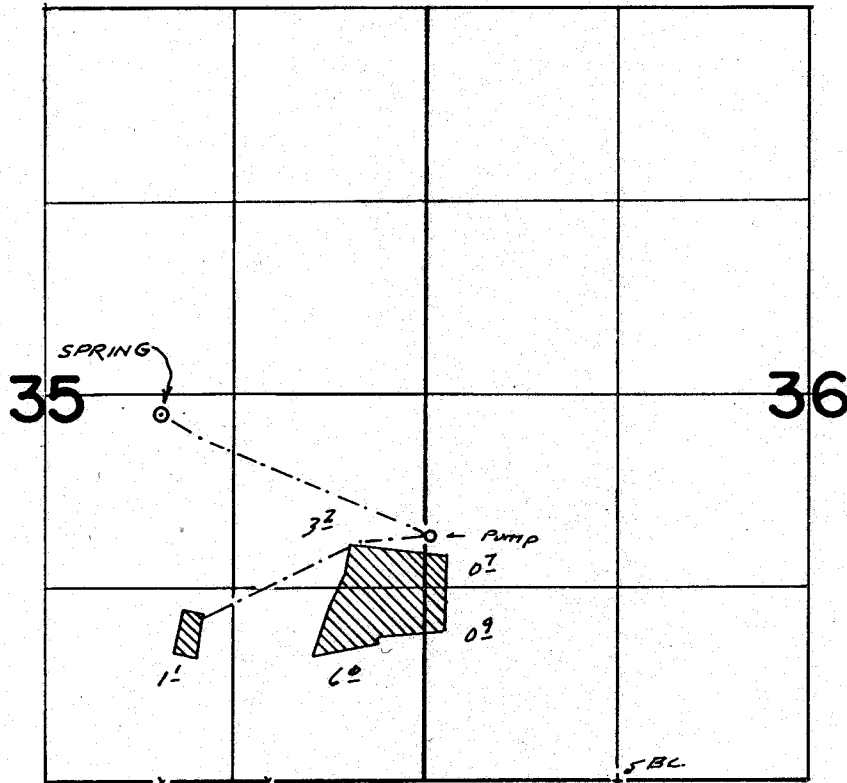

SPRING Loc: 2500' N. & 3150' W. FROM S.E. COR. SW $\frac{1}{4}$ SW $\frac{1}{4}$ SEC. 36

FINAL PROOF SURVEY UNDER

Application No. 49615... Permit No. 36706.
IN NAME OF

Mid County Cemetery Maintenance District

Surveyed Sept. 20 1977, by S.C. BROWN....