


T.25S. R.34E. W.M.

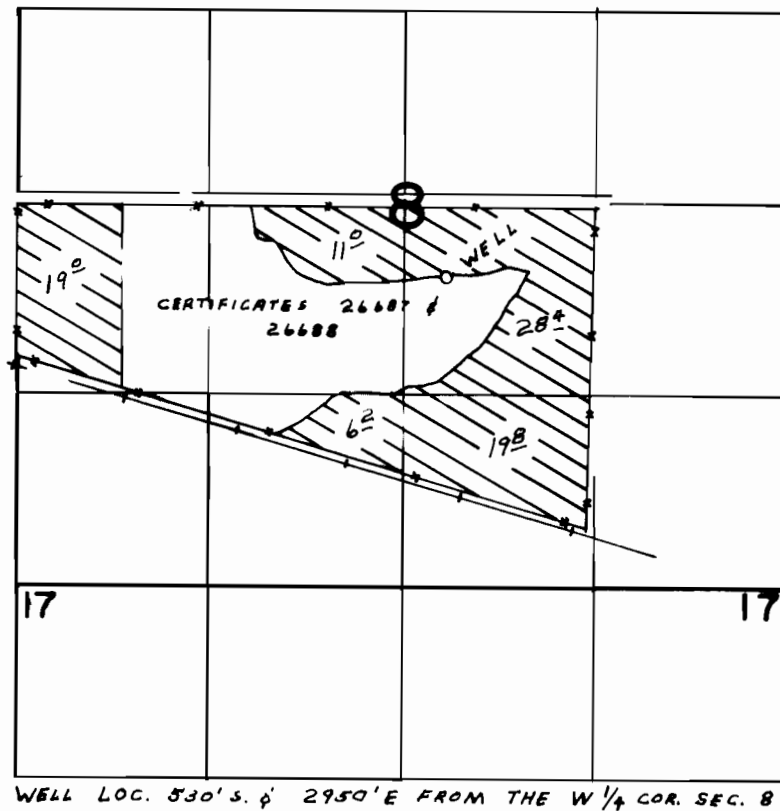

FINAL PROOF SURVEY
UNDER

Application No. G-5889 Permit No. G-5469
IN NAME OF

CLAYTON KING

Surveyed OCT. 14, 1977, by L.H. NUNN