

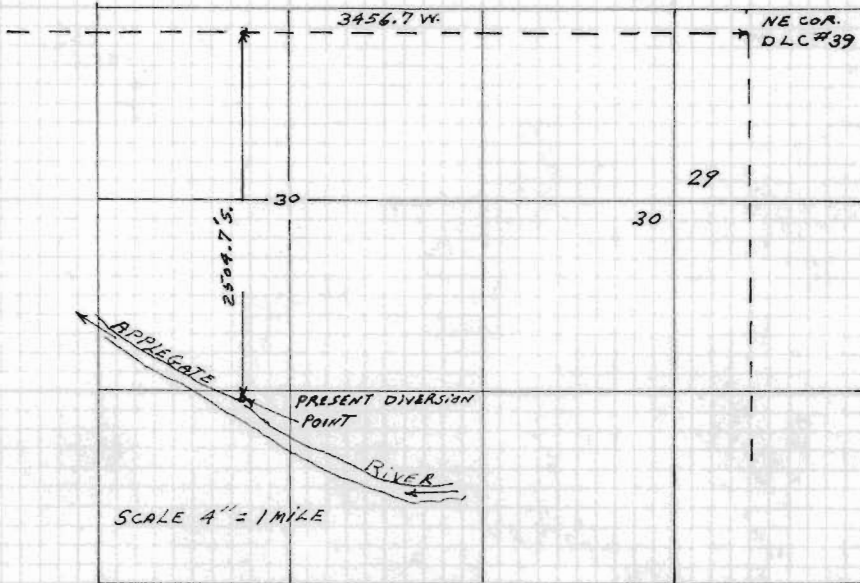


T.38S. R.3W. W.M.

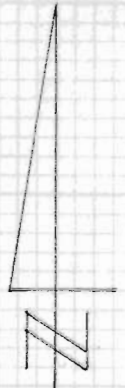

T.38S. R.4W. W.M.

N. 1/4 COR.

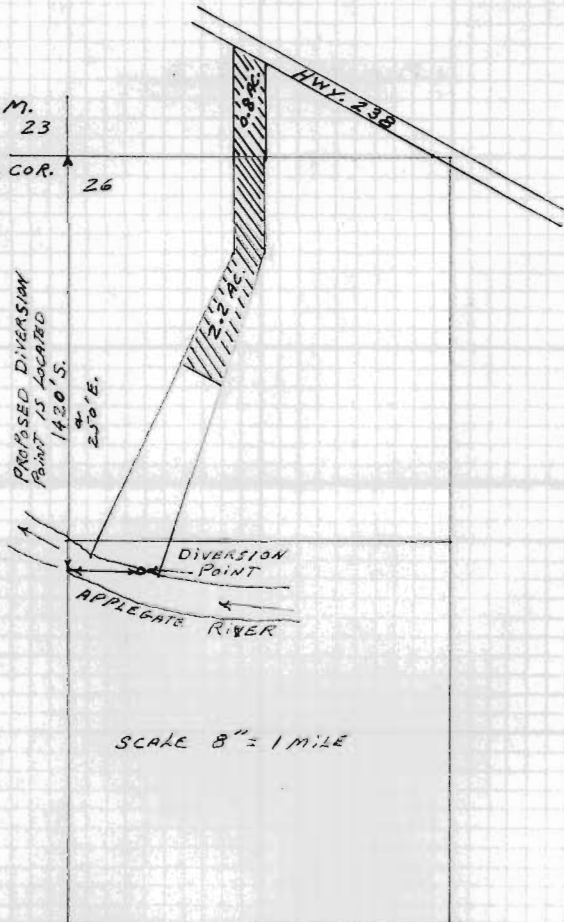

3-11-76

RECEIVED
MARCH 2 1976
WATER RESOURCES DEPT.
SALEM, OREGON

MAP TO ACCOMPANY APPLICATION OF
JOY C. NEWMAN FOR CHANGE IN
POINT OF DIVERSION

T-3377