


# T. 34S., R. 7 W., W.M.

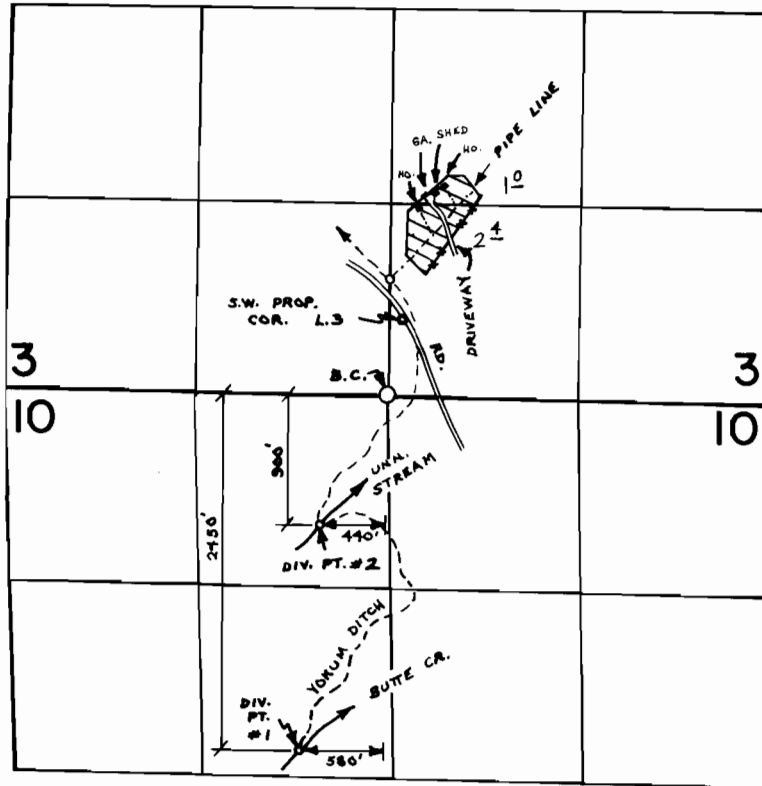

## FINAL PROOF SURVEY UNDER

Application No. 48936 Permit No. 36644  
IN NAME OF

JASPER LOY YOKUM

Surveyed OCT. 11 77 by B. SUND  
19....., by .....