


G-3957
47815

T.40S. R.IE. W.M.

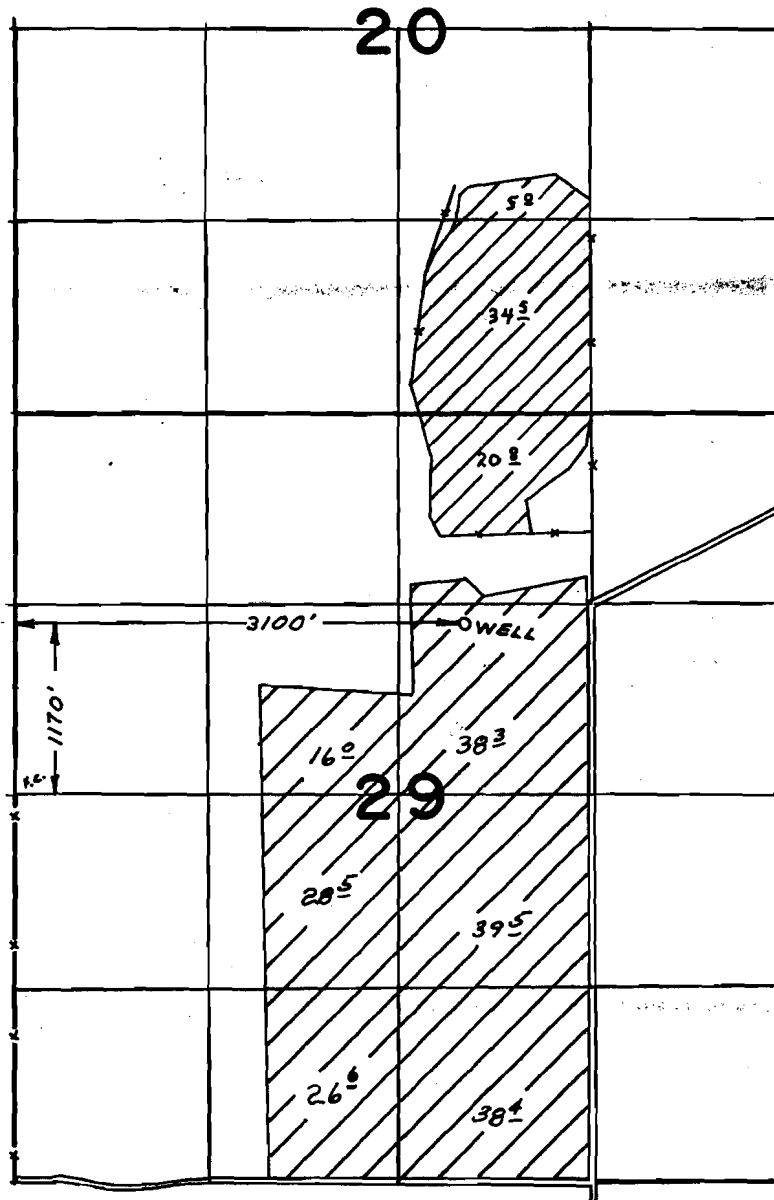

FINAL PROOF SURVEY UNDER

Application No. G-4192 Permit No. G-3957
IN NAME OF

J. RANDALL POPE

Surveyed APR. 29. 1976. by L.H. NUNN