


G-4539  
47816

# T.39S., R.13E., W.M.

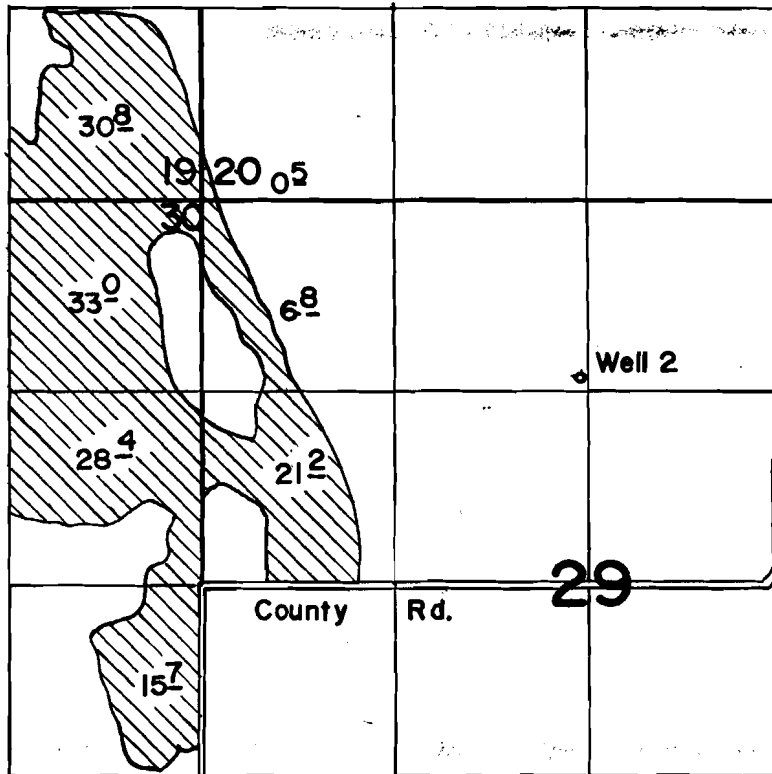

3  
2  
1  
miles W. wells

Well Located: # 2-100'N & 60'W From  
the SE cor. of the NE 1/4 NW 1/4 Sec 29

## FINAL PROOF SURVEY UNDER

Application No. G-4819. Permit No. G-4539  
IN NAME OF  
G. ROGER & KAREN HAMILTON  
..... HARRY R. WAGGONER & LUTHER R. NOBLE

Surveyed JUNE 10, 1976, by D. NORBY.....